


T.37S.,R.6W.,W.M.

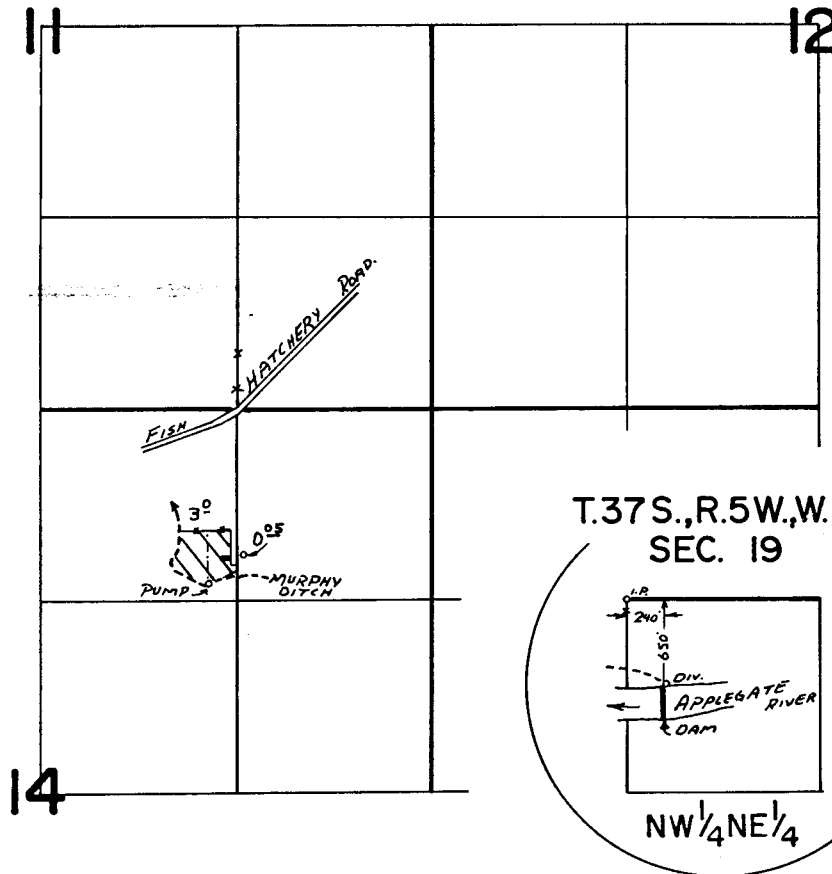

FINAL PROOF SURVEY
UNDER

RECEIVED
AUG 3 1978

WM. DIST. 14
GRANT PASS. ORE.

Application No. 52151 Permit No. 39276
IN NAME OF

ROBERT A. LONDON

Surveyed Nov. 11, 1974, by L. TOLL
APRIL 30, 1976 L. TOLL