


T.19S.,R.5W.,W.M.

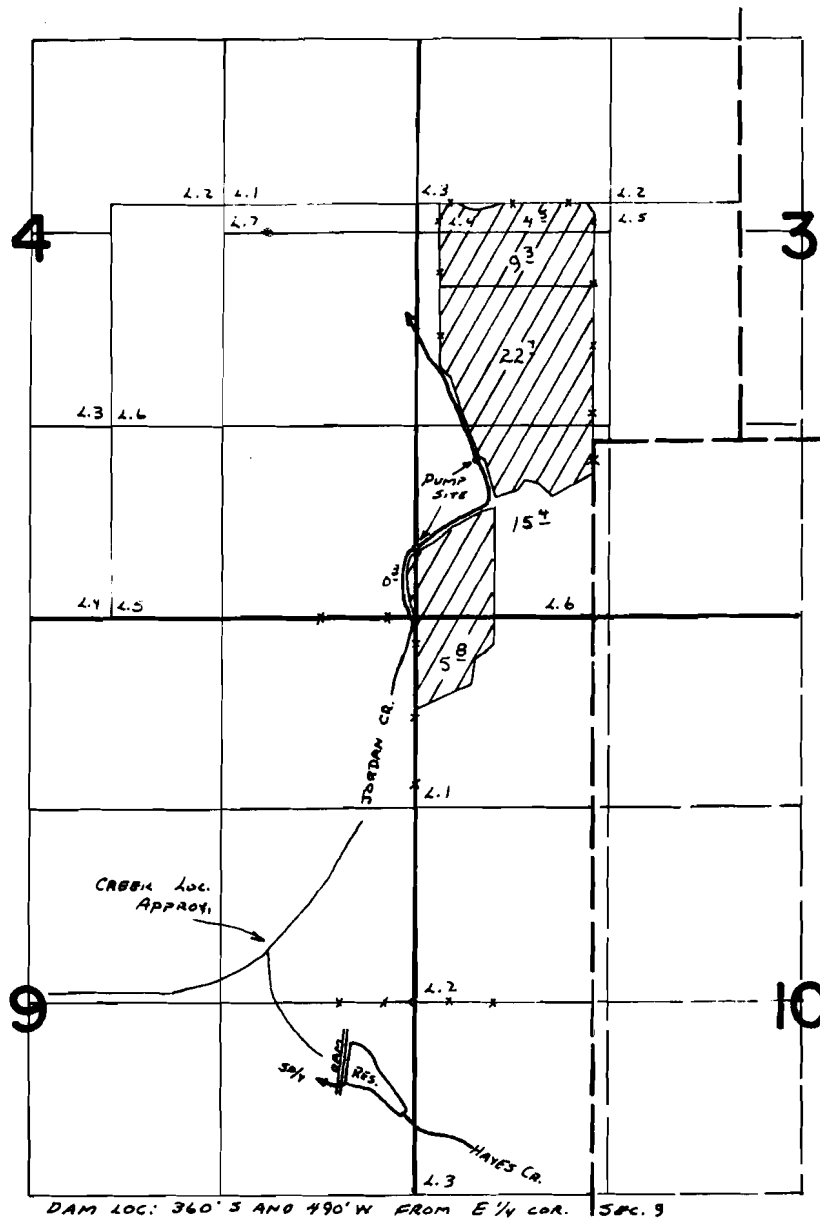

FINAL PROOF SURVEY

UNDER

Application No. **R-39574** **39643** Permit No. **R-3950** **29455**

IN NAME OF

FLEM HENDERER

Surveyed **APRIL 14 1975**, by **L. Toll**