


T.16S. R.10W. W.M.

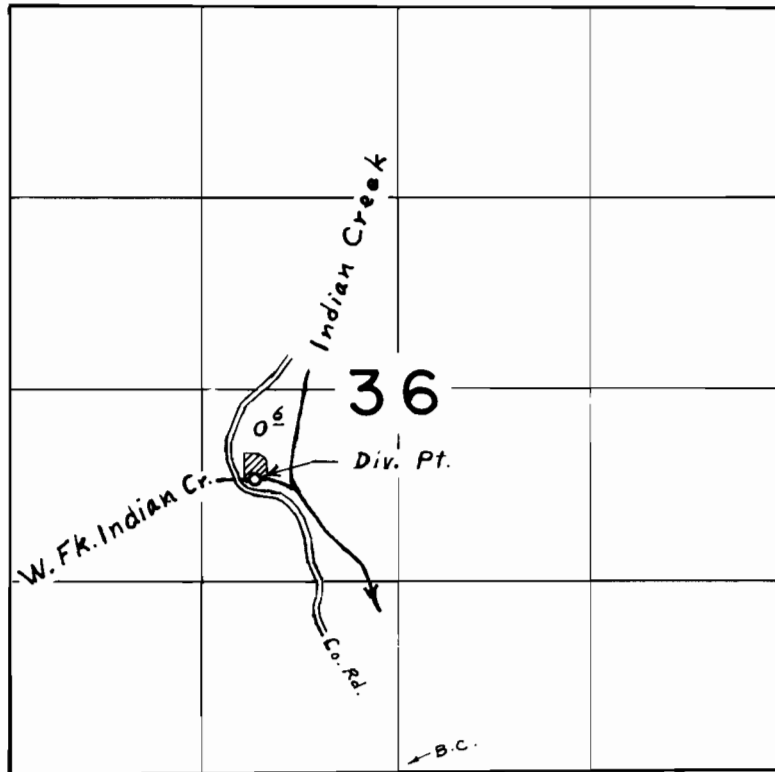

Div. Pt. located 2020' N. & 980' W. from S. $\frac{1}{4}$ Cor. Sec. 36

FINAL PROOF SURVEY
UNDER

Application No. 47058. Permit No. 35195
IN NAME OF

WAYNE W. WILKINSON

Surveyed Aug. 4, 1976, by L. E. Gould