


T. 17 S. R. 10 W. W. M.

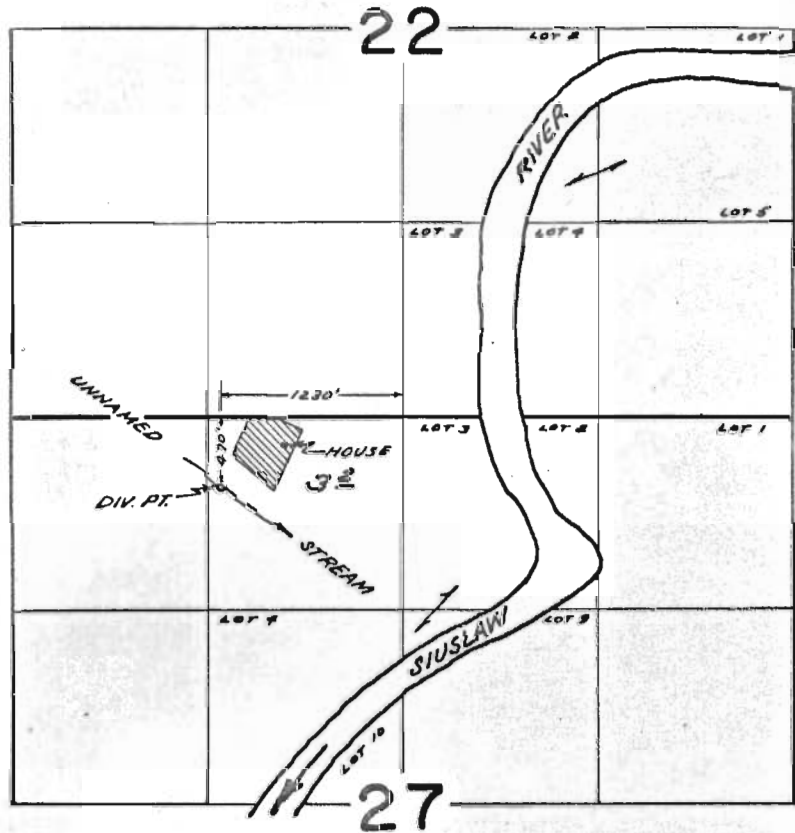

Application No. 47851

Permit No. 35862

FINAL PROOF SURVEY  
UNDER

Application No. 35822 Permit No. 29592

IN NAME OF

VERNON L. & CAROL J. VAN CURLER

Surveyed AUG. 7, 1969, by D. BUELL

File Copy