


# T.17S.R.1W.W.M.

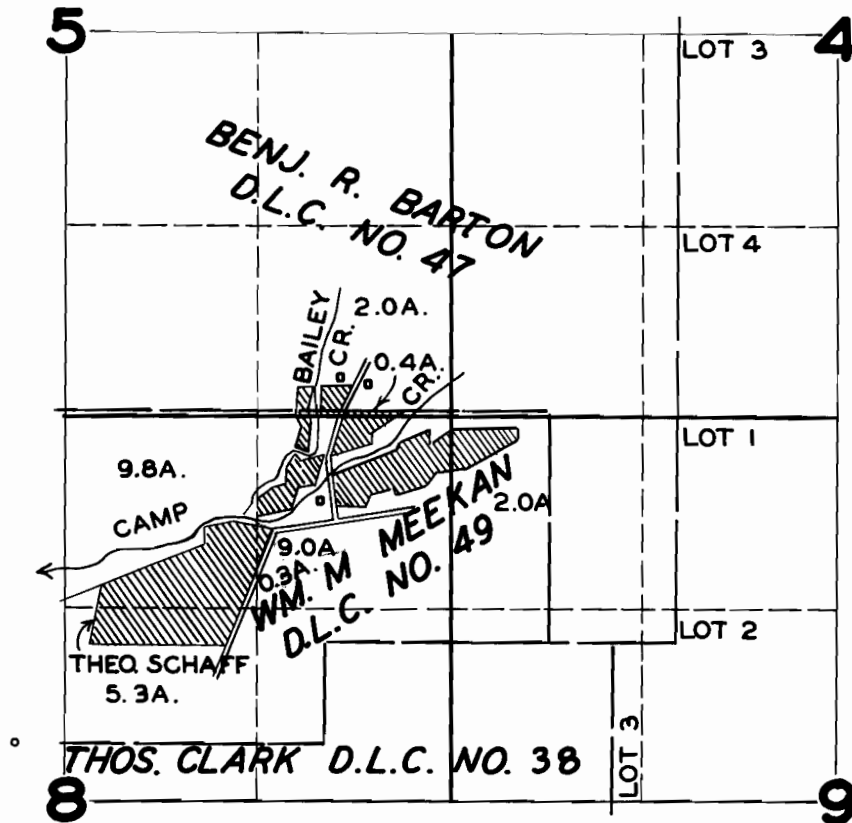

## FINAL PROOF SURVEY UNDER

Application No. **20209** .. Permit No. **15760** ..  
IN NAME OF

**GENE R. IMBACH**

Surveyed **JUNE 17, 1948**, by **JAS. E. BUNNELL**