


T. 6 S. R. 10 W. W.M.

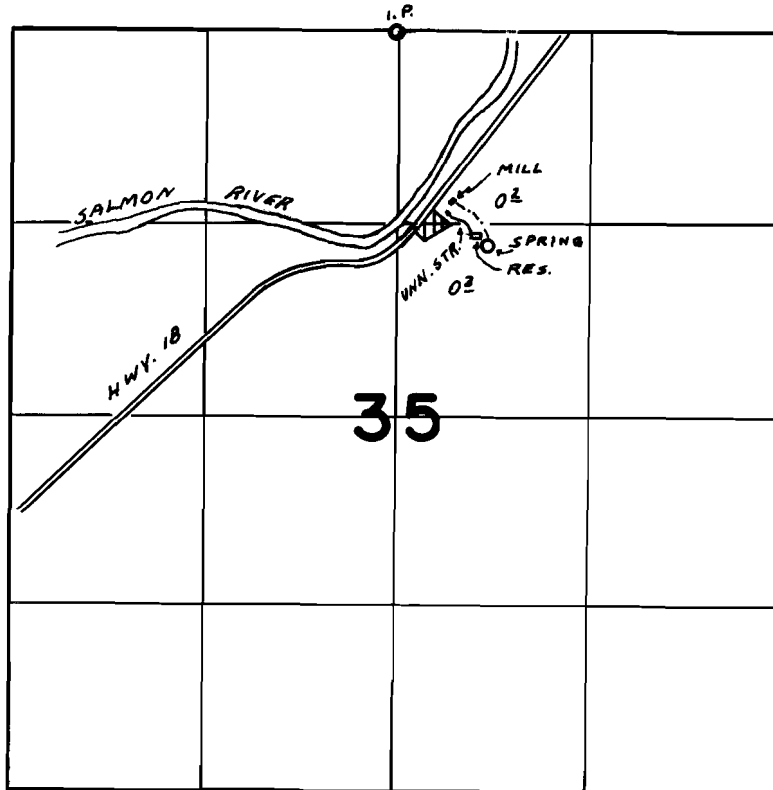

RES. LOC. 1415'S, 510' E
SPRING LOC. 1490'S, 610' E
BOTH FROM N 1/4 COR. SEC. 35

FINAL PROOF SURVEY UNDER

R 48045 R 5654
Application No. 48046 Permit No. 35261
IN NAME OF

LARRY D. KESSLER

Surveyed JUNE 28 1976, by C.R. KING