


T.19S. R.47E. W.M.

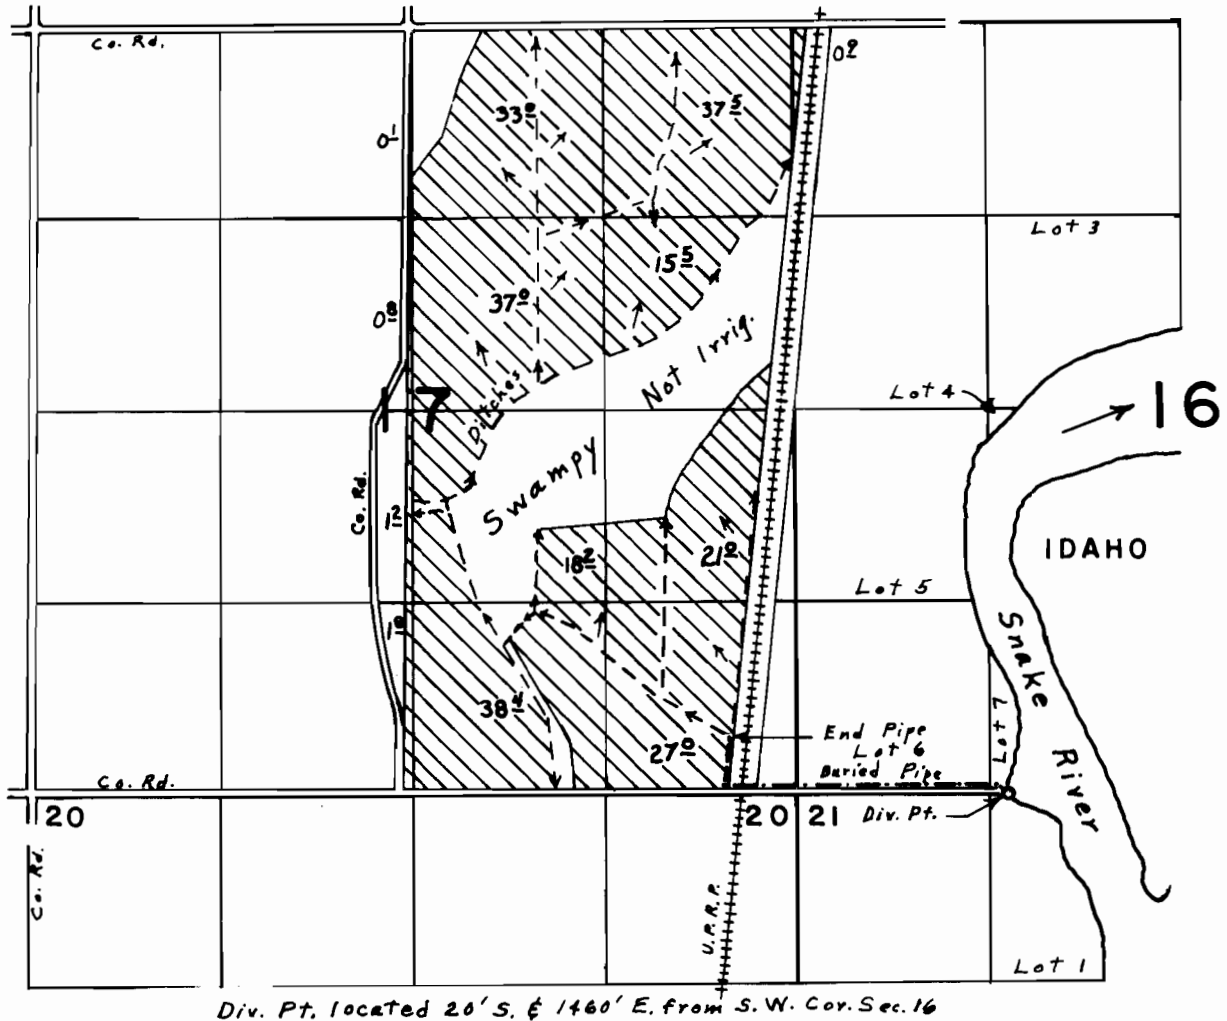

FINAL PROOF SURVEY UNDER

Application No. 51568 Permit No. 37440
IN NAME OF

TRAVELERS INS. / J. A. ALBERTSON

Surveyed May 6, 1976, by L. E. Gould