


T.6S.,R.1E.,W.M.

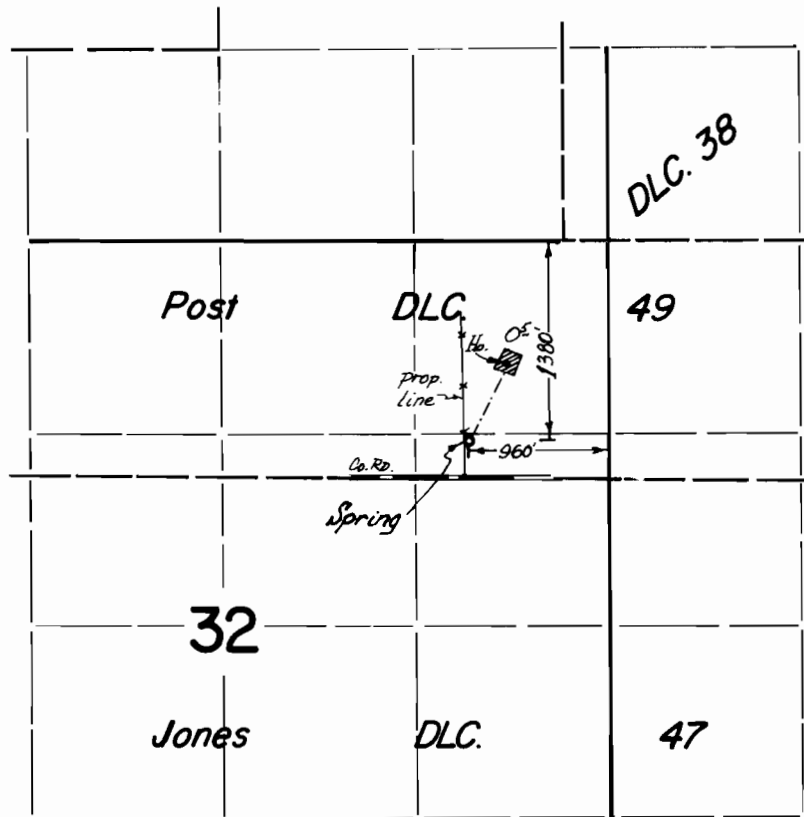

FINAL PROOF SURVEY
UNDER

Application No. 51972 Permit No. 37655
IN NAME OF

MALCOLM B. HIGGINS

Surveyed Sept. 8 1977, by R.G. Mucken