


T.6S.,R.8W.,W.M.

SEC. II

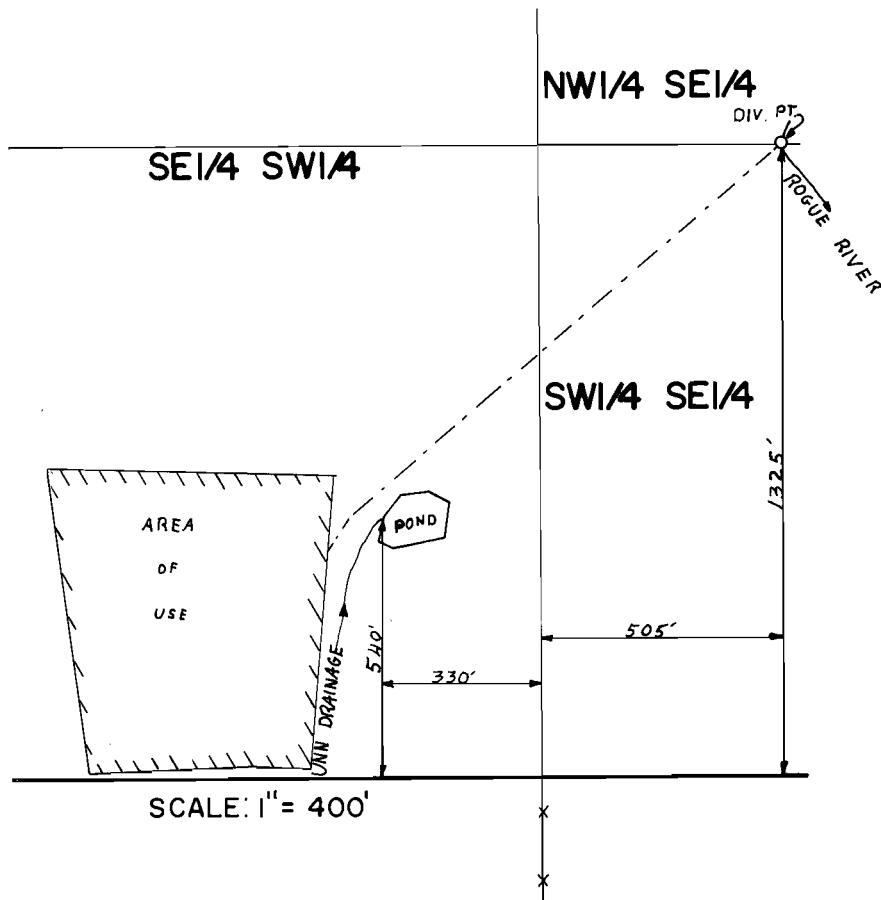

FINAL PROOF SURVEY UNDER

R-53391 R- 6383
Application No.53392. Permit No.39864.
IN NAME OF

ERICKSON HARDWOOD COMPANY.

Surveyed AUG...9... 1976., by C.R...KING.....