


T.6S.,R.8W.,W.M.

SEC. II

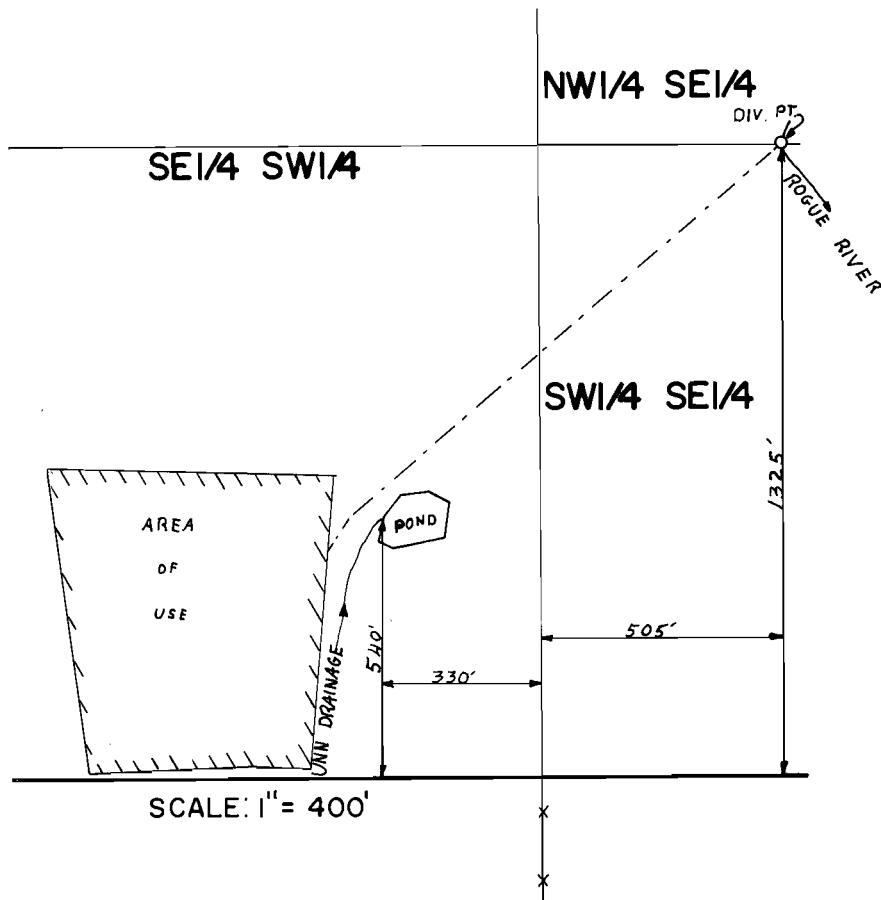

FINAL PROOF SURVEY UNDER

R-53391

R- 6383

Application No.53392. Permit No.39864.

IN NAME OF

ERICKSON HARDWOOD COMPANY.

Surveyed AUG...9... 1976., by C.R. KING.....