


T.7S. R.4W. W.M.

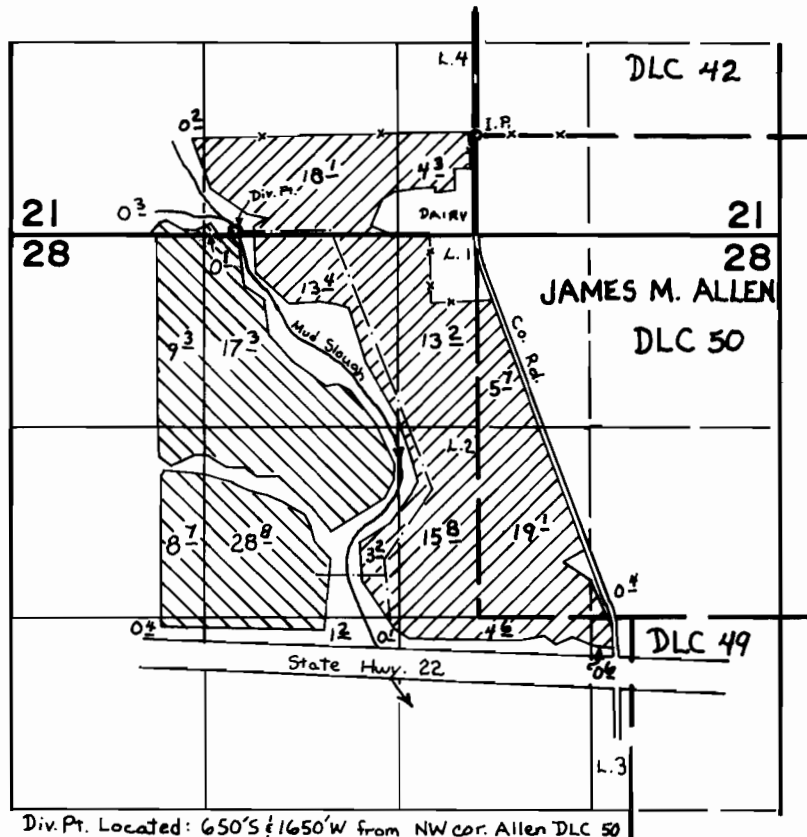

FINAL PROOF SURVEY
UNDER

Application No. 50301 37979 51782 Permit No. 39012
IN NAME OF

BICE DAIRY CORPORATION

Surveyed MAY 20, 1976, by C. KING