


T. 2N. R. 33E. W.M.

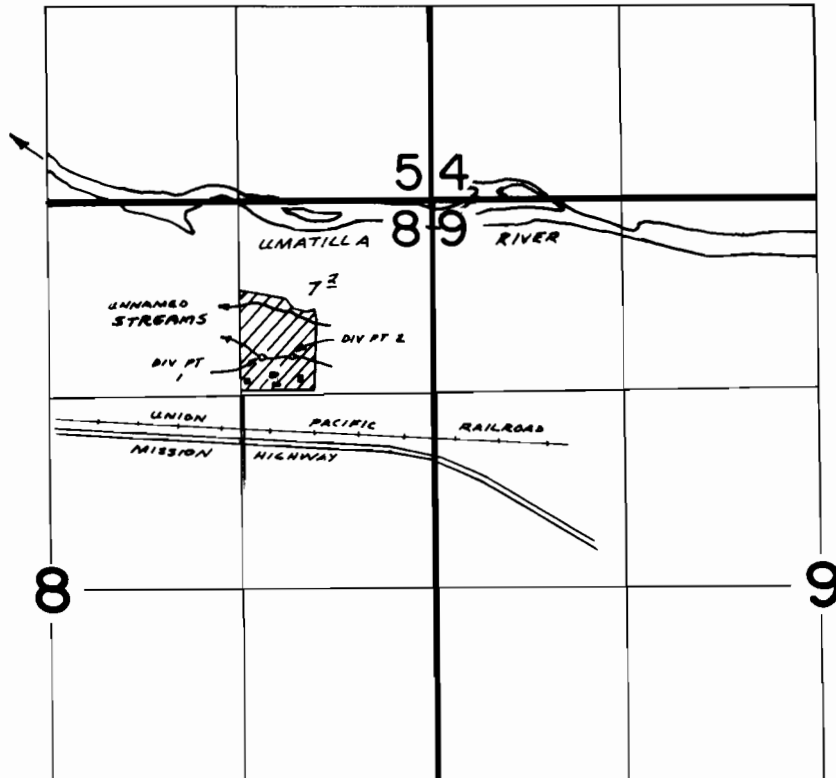

DIVERSION POINT 1 LOCATED 270' N. & 150' E. FROM SW COR NE 1/4 NE 1/4 SEC 8
DIVERSION POINT 2 LOCATED 270' N. & 360' E. FROM SW COR NE 1/4 NE 1/4 SEC 8

FINAL PROOF SURVEY UNDER

Application No. 51577..... Permit No. 38905.....
IN NAME OF

.....ASHLEY PRINCE & HOWARD DAVIDSON.....

Surveyed SEPT. 29. 19.77., by ..R. BARWIN.....