


T.4S.,R.39E.,W.M.

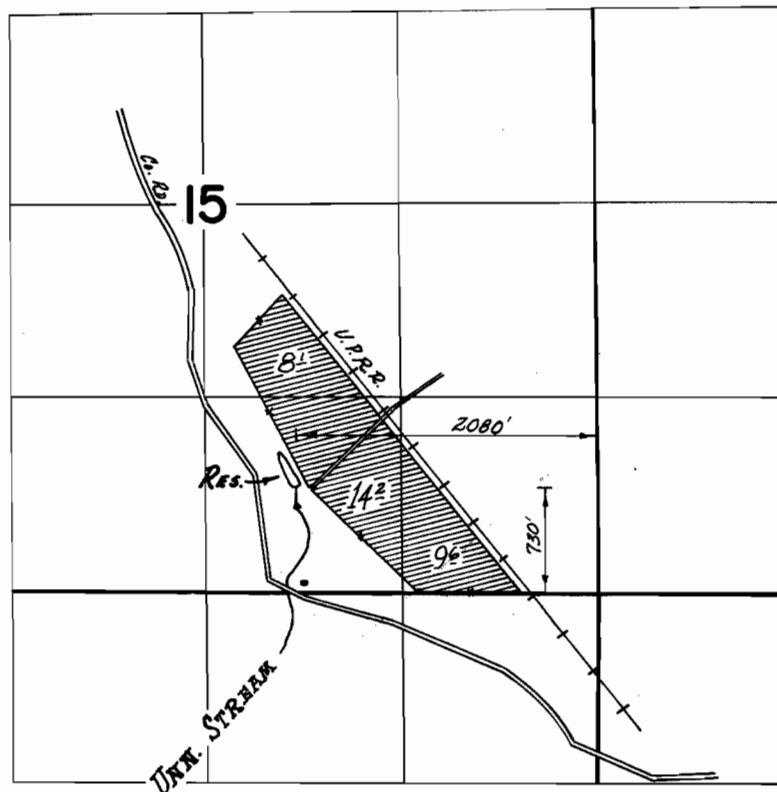

FINAL PROOF SURVEY
UNDER

R-48253 R-5867
Application No. 48254 Permit No. 36232
IN NAME OF

WILLIAM A. & ROBERT M. REED

Surveyed July 12 1973, by D. NORBY