


T. 3S. R. 40E. W.M.

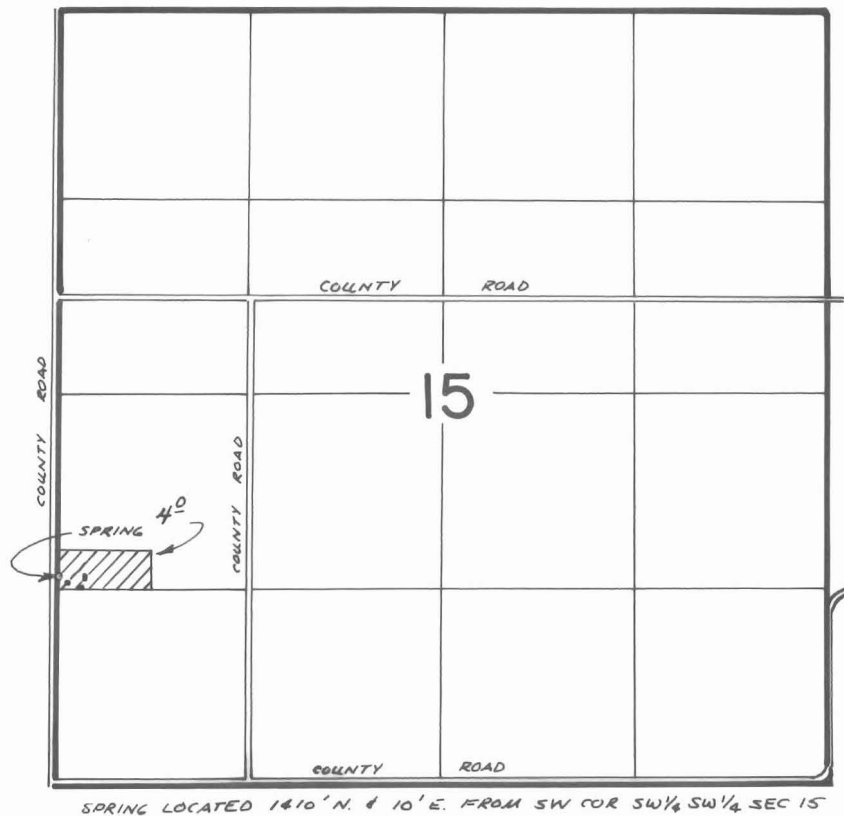

FINAL PROOF SURVEY UNDER

Application No. 52131 Permit No. 38412
IN NAME OF

MURIEL L. & ROSE HELEN RUNDALL

Surveyed OCT. 18. 1977., by R. BARWIN.....