


T. 1 S. R. 2 W. W. M.

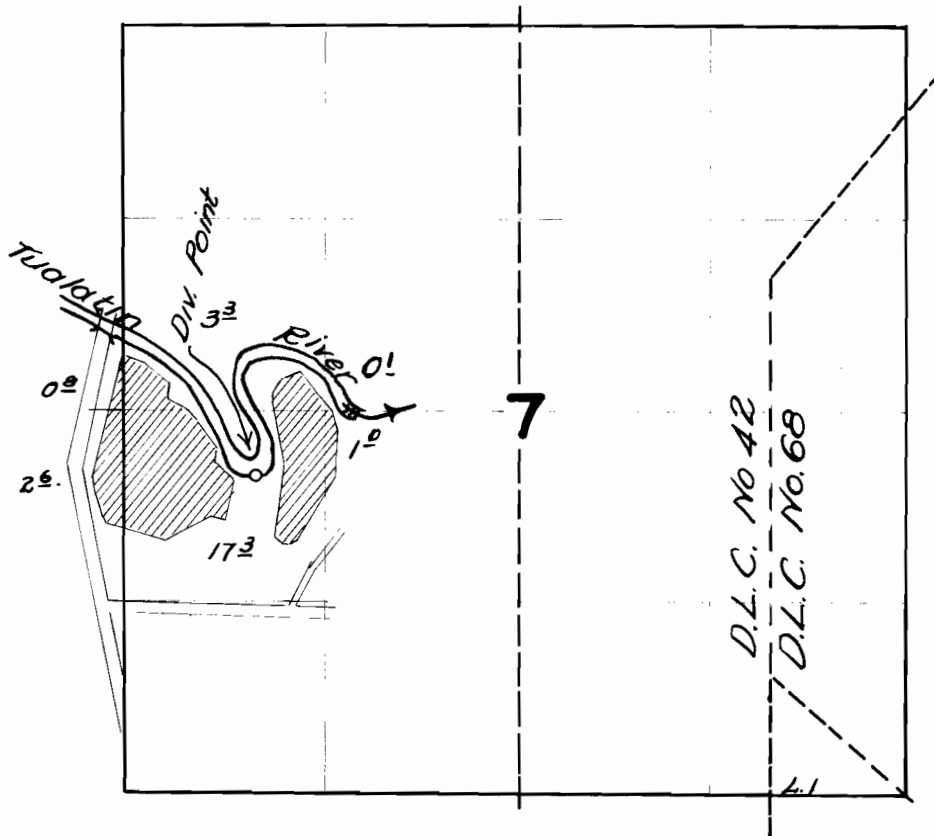

FINAL PROOF SURVEY UNDER

Application No. 23421 Permit No. 18489
IN NAME OF

CARL E. PIERSON

Surveyed 7/13 1951, by H.L. COFFMAN