


# T. 1 & 2 S. R. 2 W. W. M.

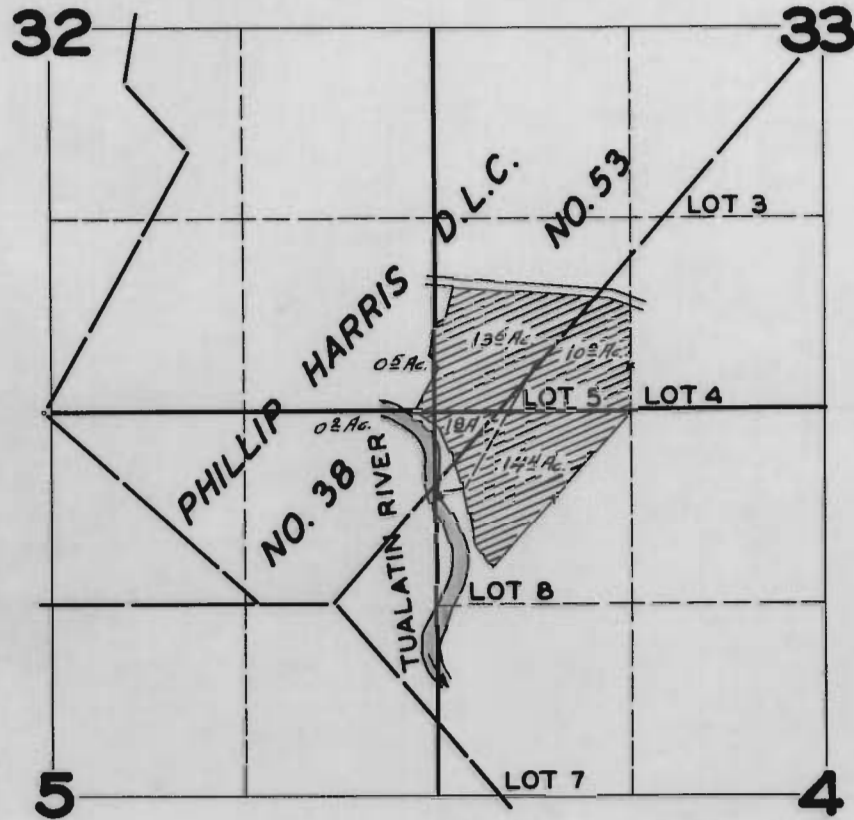

## FINAL PROOF SURVEY UNDER

Application No. 17742 Permit No. 13437  
IN NAME OF

VERNON W. ALEXANDER

Surveyed JULY 17, 1947, by JAS. E. BUNNELL