


T.5&6S. R.5W. W.M.

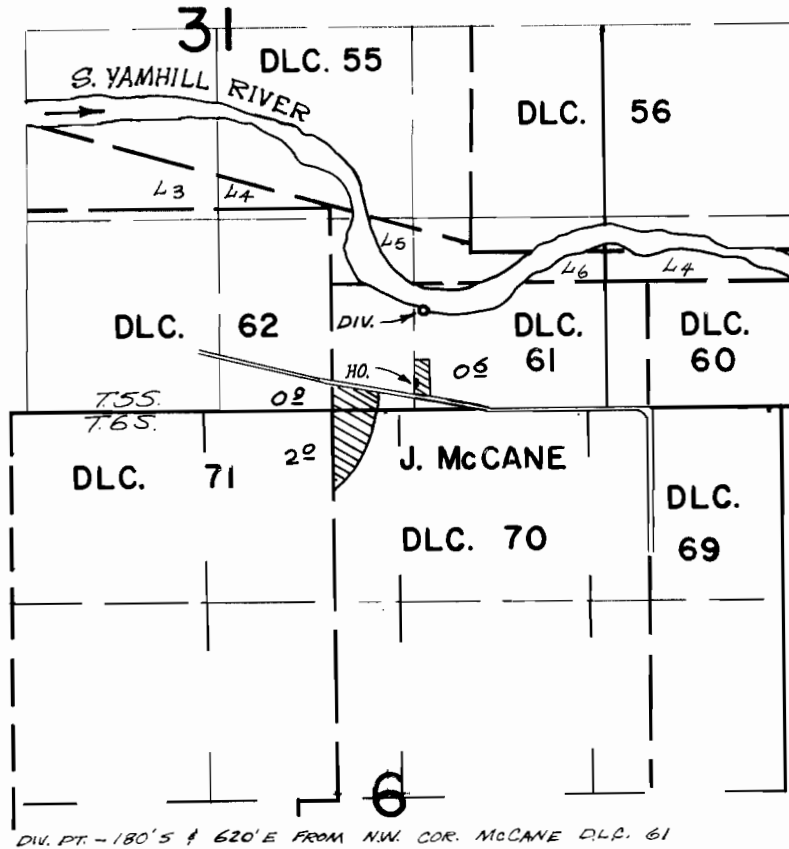

FINAL PROOF SURVEY
UNDER

Application No. 49569 Permit No. 36413
IN NAME OF

GRACE STUTZMAN

Surveyed MAY 31 1973, by R. MUCKEN