


T.5S. R.8W. W.M.

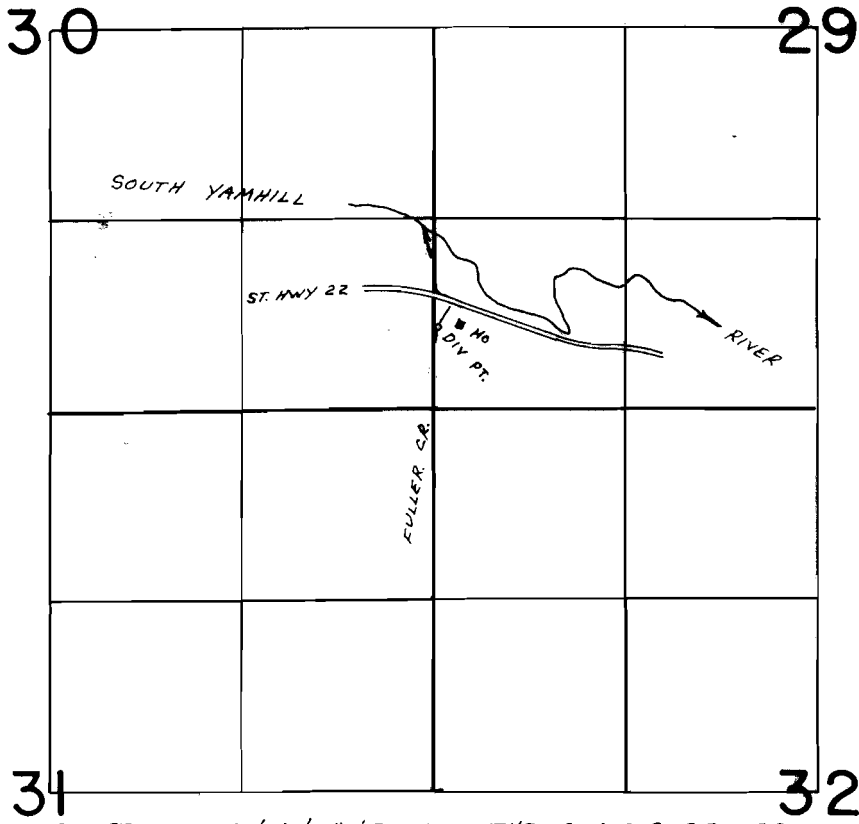

DIV. PT. LOC. 560' N. & 40' E. FROM THE SW COR. SEC. 29.

FINAL PROOF SURVEY
UNDER

Application No. 53704... Permit No. 40149...
IN NAME OF

...ETTA PEARL DEAN NEWMAN...

Surveyed SEP. 8, 1977, by L.H. NUNN...