


T.12S.,R.48&5W.,W.M.

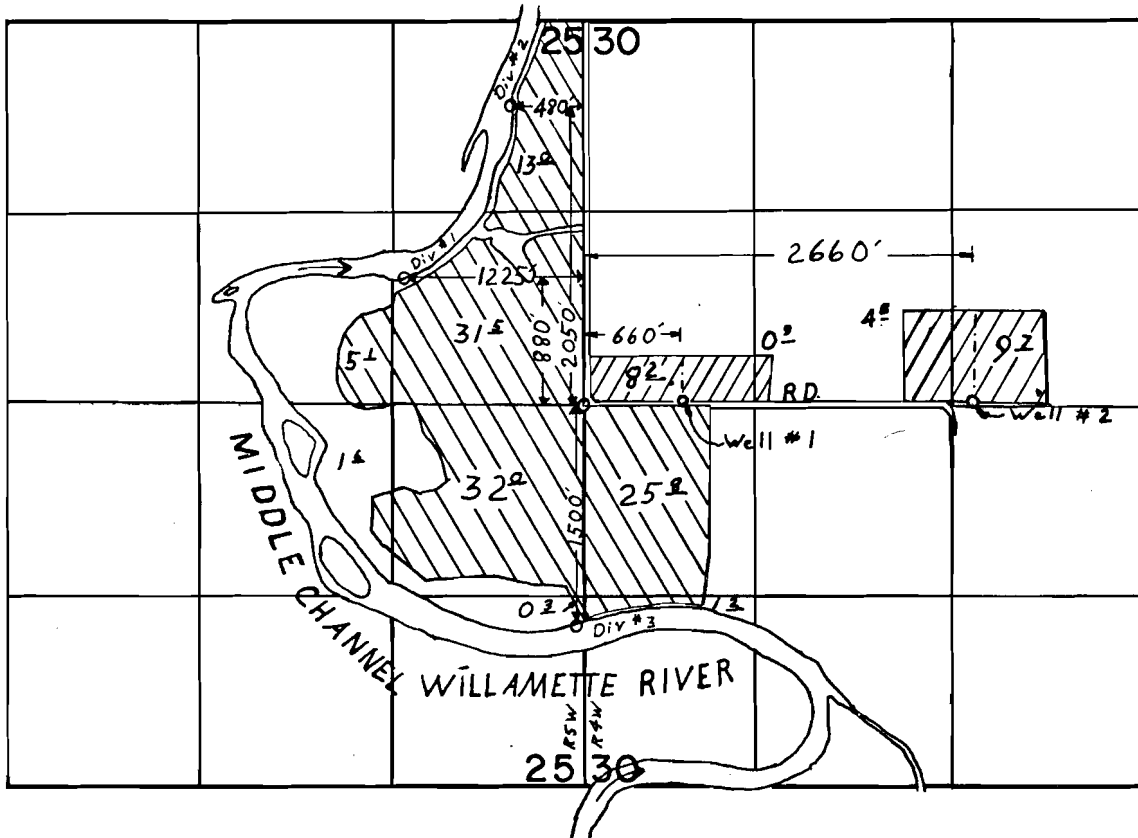

FINAL PROOF SURVEY
UNDER

Application No. **G-5373** 52765 Permit No. **G-5308** 37776 
IN NAME OF

ROY HATHAWAY

Surveyed APR. 20. 1976, by G.R. KING.....