


T.8S.R.39E.W.M.

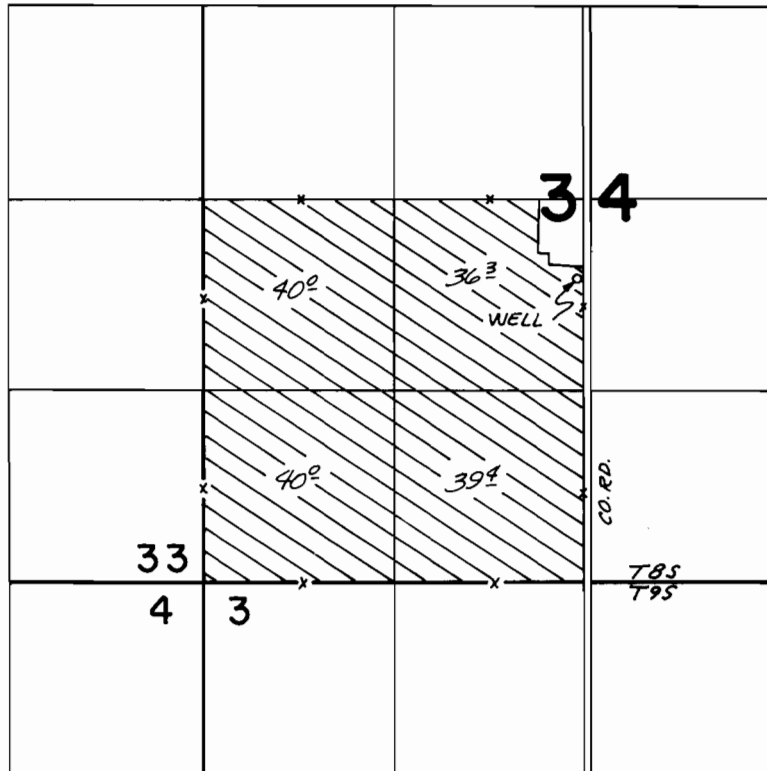

WELL LOCATED 550' S. & 60' W. FROM CENTER SEC. 34.

FINAL PROOF SURVEY UNDER

Application No. 66699 Permit No. 66210
IN NAME OF

DON HILL

Surveyed JUNE 19 1976, by C.R. KING