


T.12 S.R.5W.W.M.

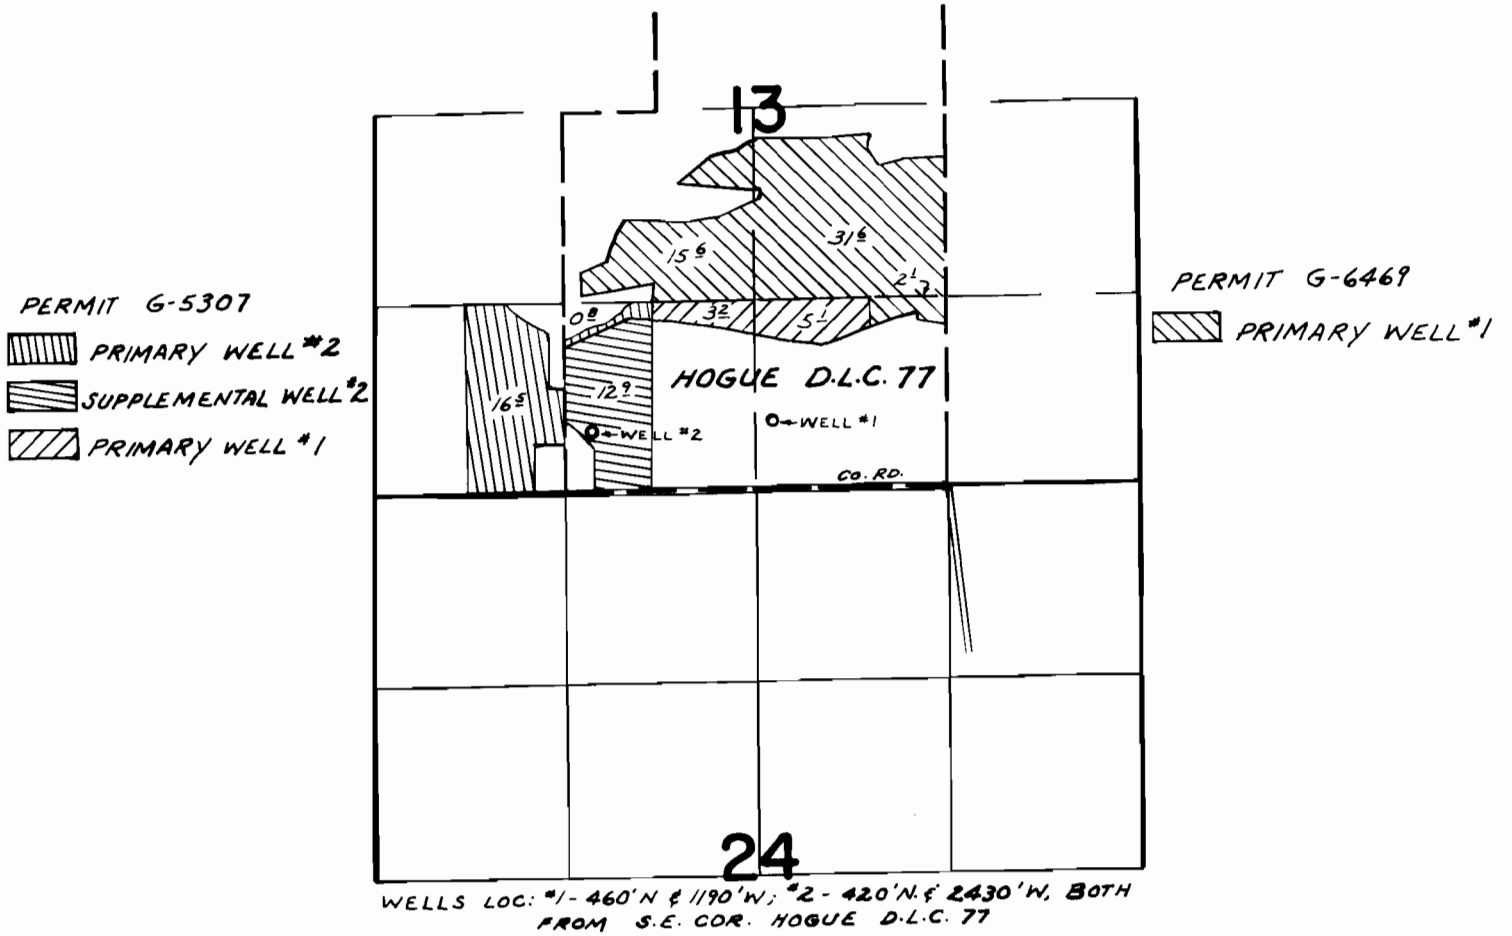

FINAL PROOF SURVEY UNDER

G-6957 G-6469
 Application No. ~~G-5372~~ Permit No. ~~G-5307~~
 IN NAME OF

ROY HATHAWAY

Surveyed APR. 11, 1978, by V.S. DONALDSON