


# T.12 S.R.5W.W.M.

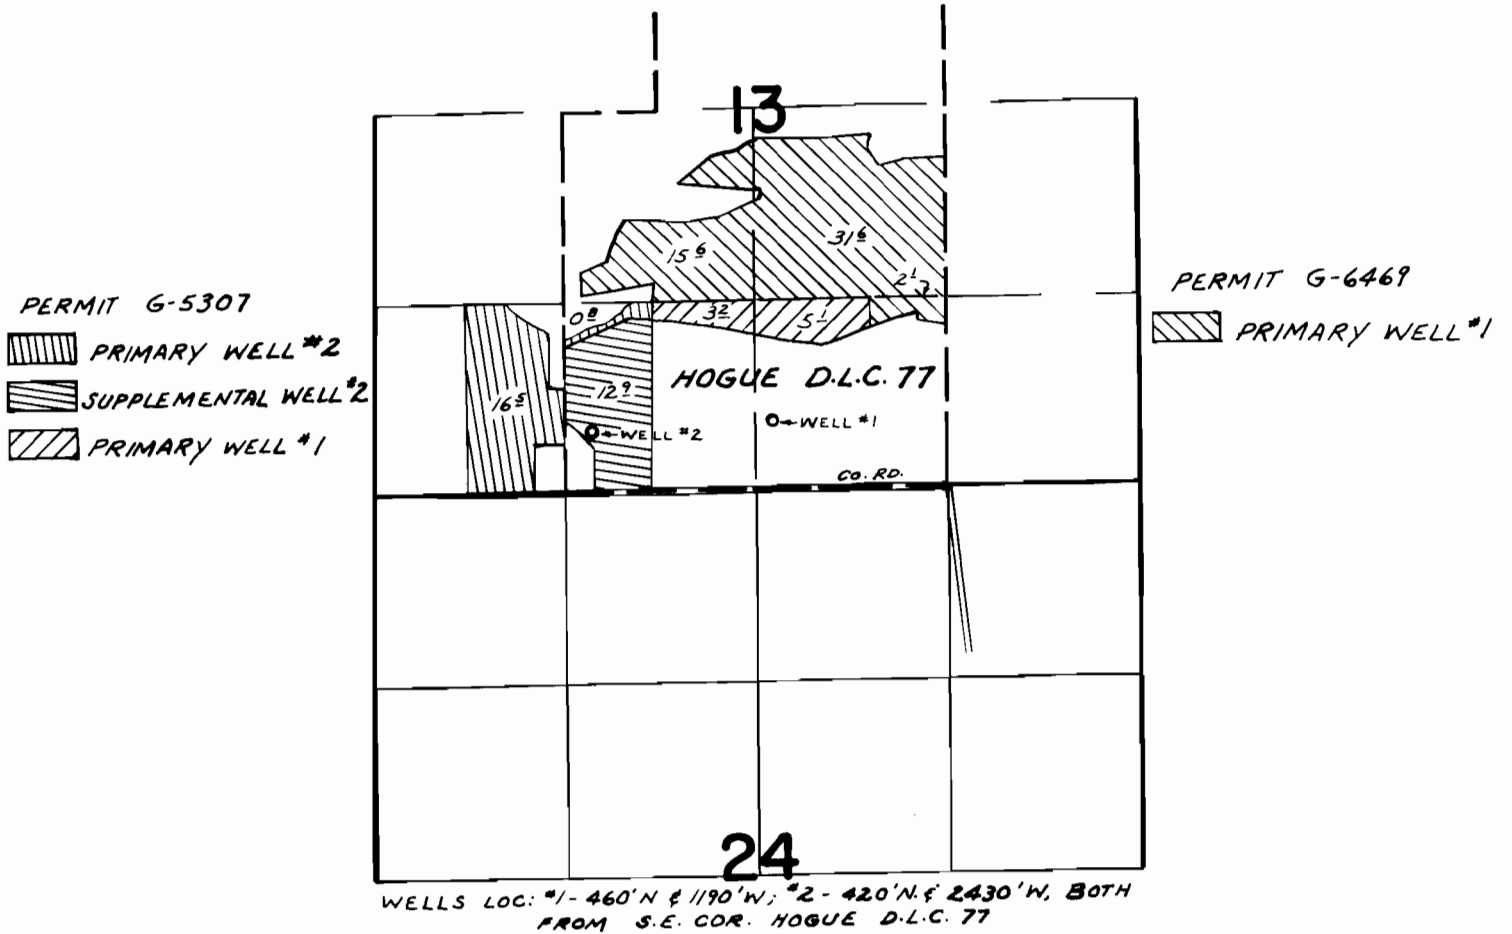

## FINAL PROOF SURVEY UNDER

G-6957                      G-6469  
 Application No. ~~G-5372~~ Permit No. ~~G-5307~~  
 IN NAME OF

ROY HATHAWAY

Surveyed APR. 11, 1978, by V.S. DONALDSON