


T.12S.,R.6W., W. M.

NE 1/4 SE 1/4 SEC. 31

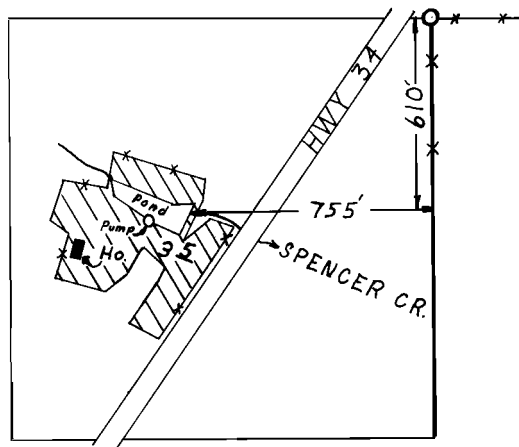

SCALE: 1" = 600'

FINAL PROOF SURVEY
UNDER

Application No. 43994 Permit No. 32890
IN NAME OF

KENNETH D. & JOAN KIZER

Surveyed JULY...6.. 1976, by C.R. KING.....