


T.15S.R.5W.W.M.

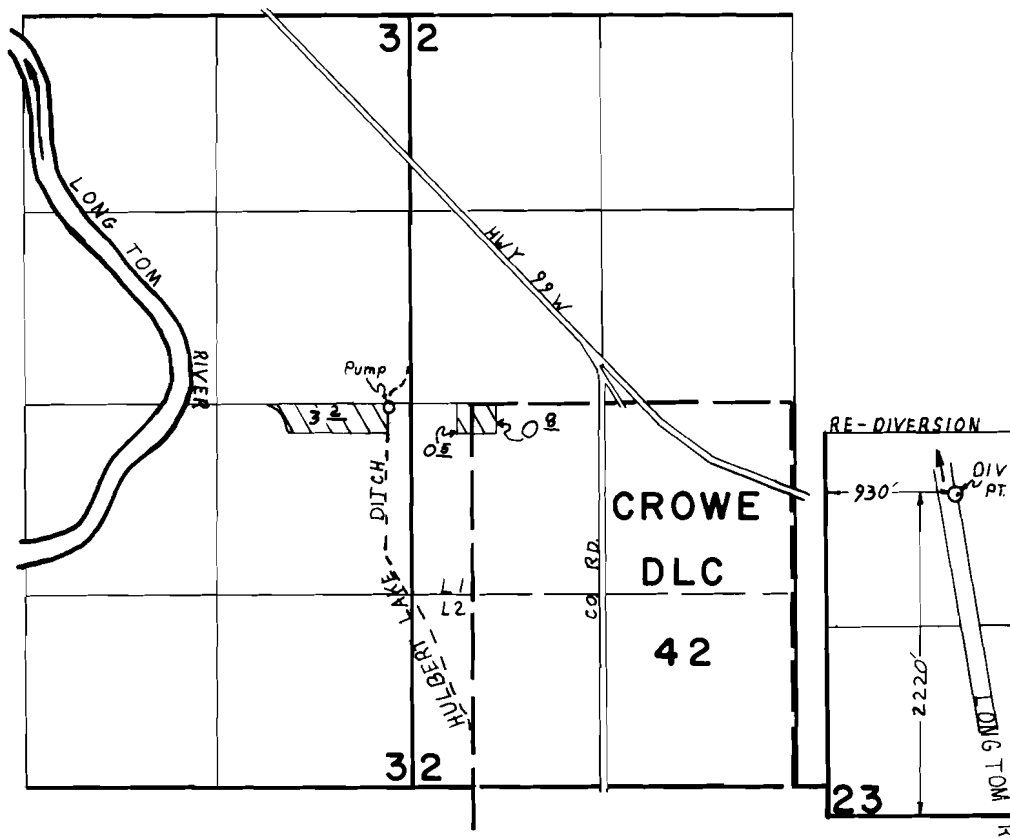

FINAL PROOF SURVEY
UNDER

Application No. 45075 Permit No. 35700
IN NAME OF

GLENN ARNOLD SEAMAN

Surveyed APR. 22. 1976, by C.R. KING