


T.10S.R.6W.W.M.

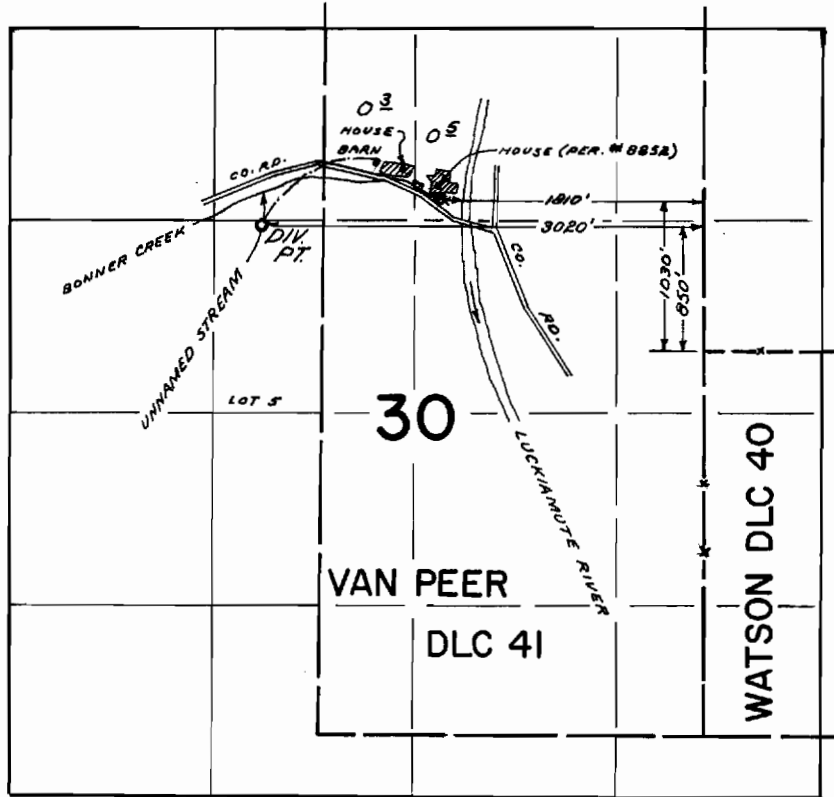

Application No. 51357 Permit No. _____

IN NAME OF

VERNA M. PROBST

Surveyed September 17, 1971, by Donald R. Buell