


T.13S. R.5W.W.M.

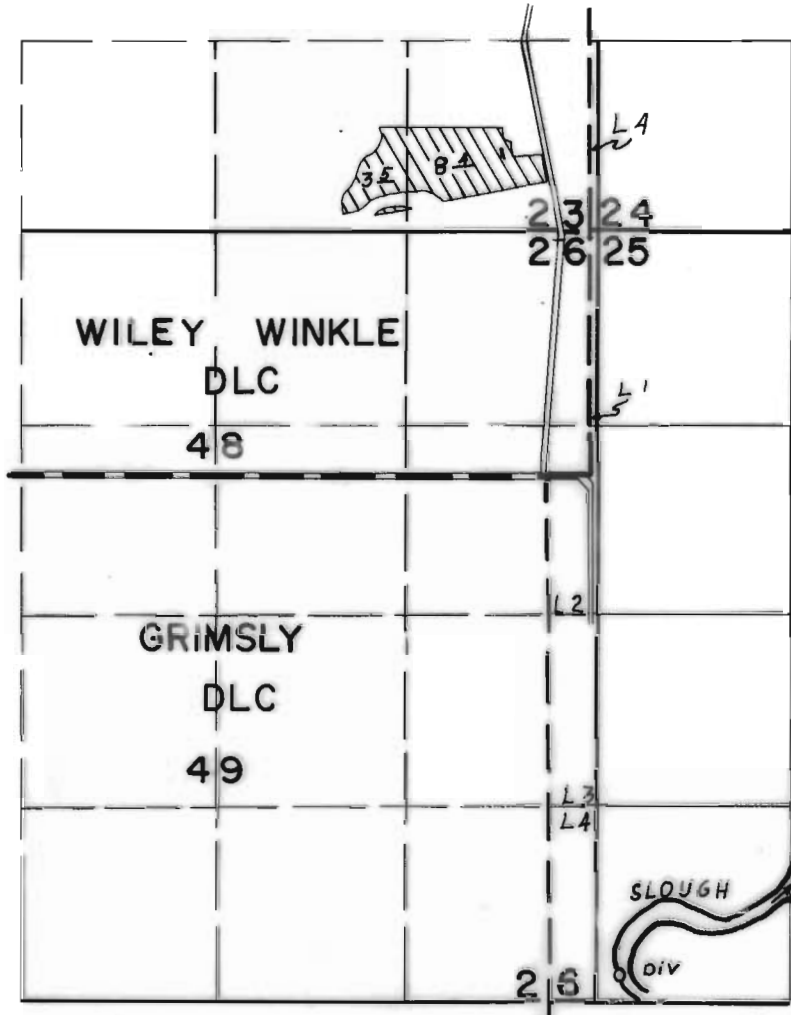

DIV: 180' N & 160' E FROM SW COR SEC 25

FINAL PROOF SURVEY
UNDER

Application No. 51590... Permit No. 38620...
IN NAME OF

GALE ALLEN MILLER

Surveyed APR... 1976, by C.R. KING.....