


T.11&12S. R.5W.W.M.

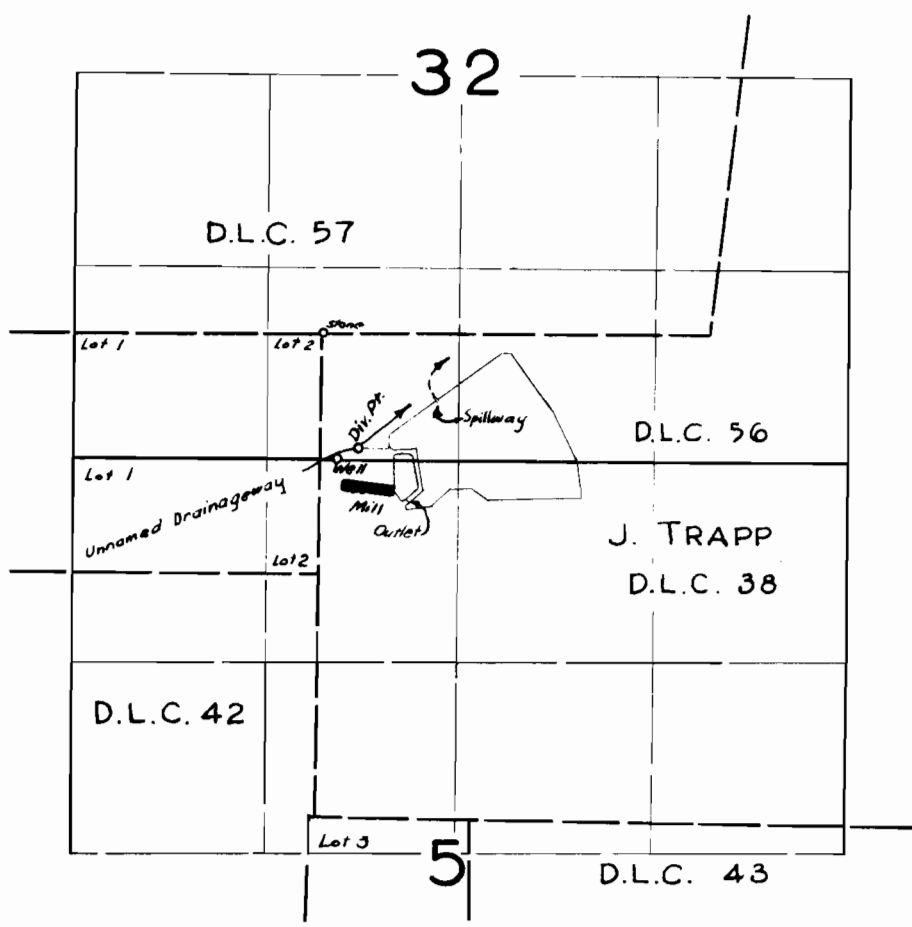

FINAL PROOF SURVEY UNDER

Application No. ^{G-282} ~~R-28446~~ 28494 Permit No. ^{G-271} ~~R-1627~~ 22967
IN NAME OF

Surveyed 12 March 1959, by R.H. Jackson