


T.3 S. R.3 E. W.M.

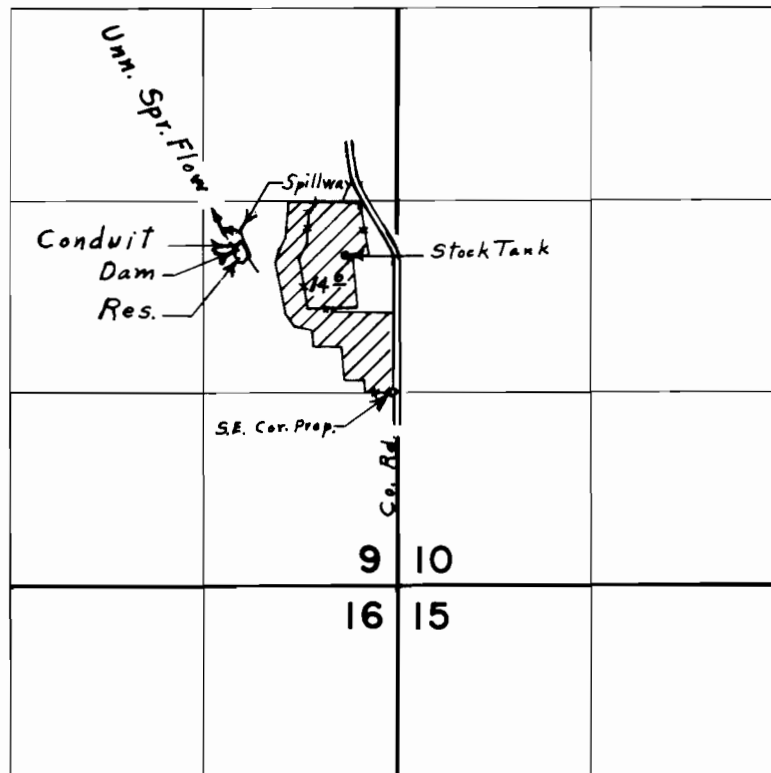

Div. Pt. loc. 1000' N. & 1100' W. from S.E. Cor. N.E. $\frac{1}{4}$ SE. $\frac{1}{4}$ Sec. 9

FINAL PROOF SURVEY
UNDER

R-49417 R-6011
Application No. 49418 Permit No. 37030
IN NAME OF

HENRY SCHUVER

Surveyed June 1, 1976, by L. E. Gould