


T.3 S. R.3 E. W.M.

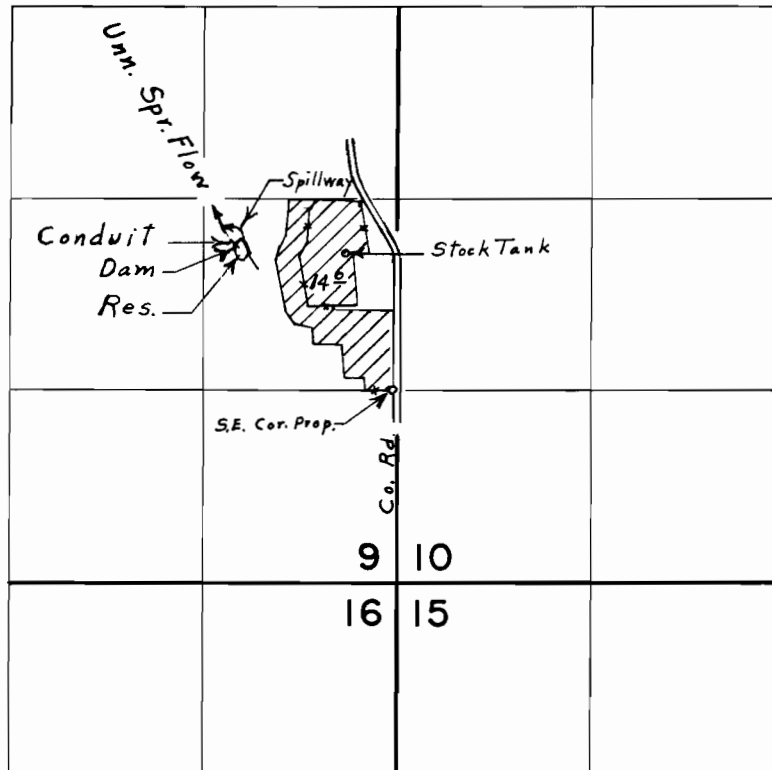

Div. Pt. loc. 1000' N. & 1100' W. from S.E. Cor. N.E.  $\frac{1}{4}$  SE.  $\frac{1}{4}$  Sec. 9

**FINAL PROOF SURVEY**  
UNDER

R-49417 R-6011  
Application No. 49418 Permit No. 37030  
IN NAME OF

HENRY SCHUVER

Surveyed June 1, 1976, by L. E. Gould