


T. 4S. R. 3E. W.M.

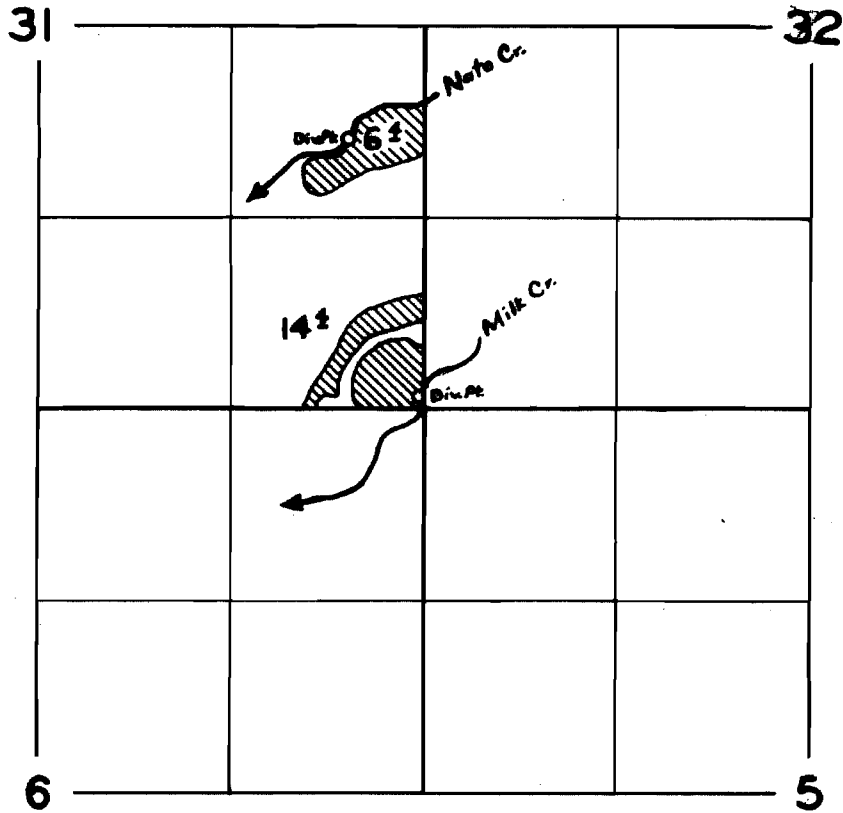

FINAL PROOF SURVEY

UNDER

Application No. ~~22906~~ Permit No. ~~10177~~.....

IN NAME OF

HENRY & RUTH KNUDSEN

Surveyed 15 Mar. 1955, by R.D. Best