


T.8N.,R.8W.,W.M.

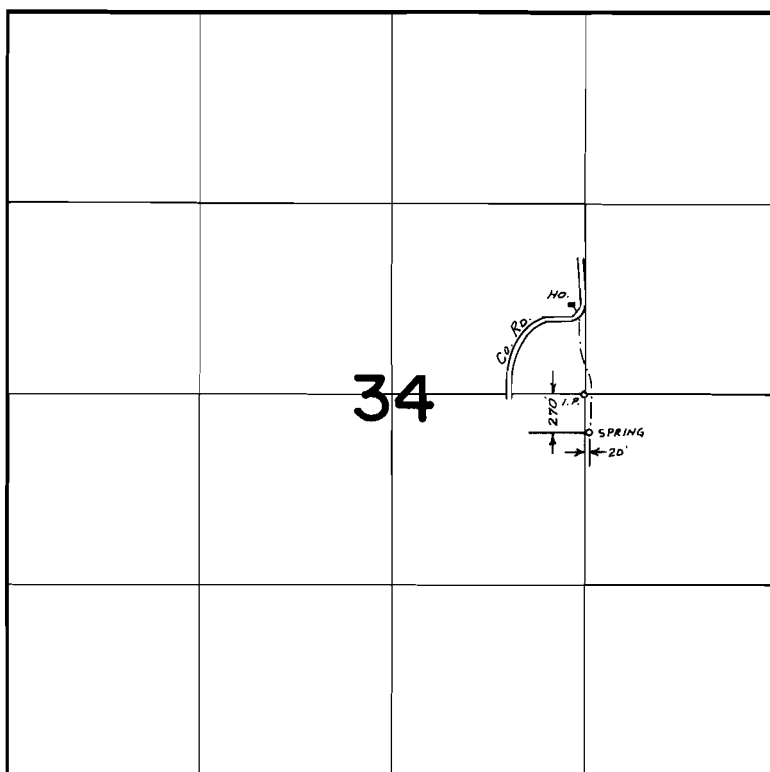

FINAL PROOF SURVEY
UNDER

Application No. 50170 Permit No. 37867
IN NAME OF

RUTH E. THOMPSON

Surveyed JUNE 23 1976, by L. TOLL