


T. 7 N. R. 5 W. W.M.

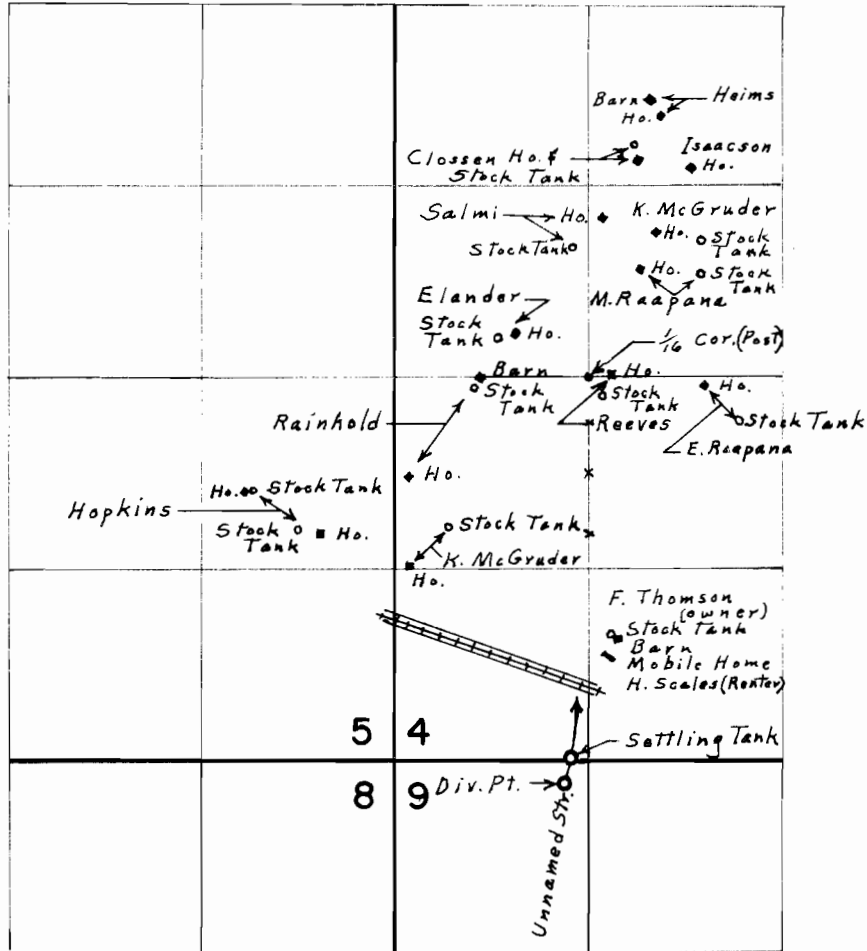

Div. Pt. located 2790' S. & 150' W. from N.E. Cor. N.W. $\frac{1}{4}$ S.W. $\frac{1}{4}$ Sec. 4

FINAL PROOF SURVEY UNDER

Application No. 41137 Permit No. 30669
IN NAME OF

WOODSON WATER ASSOCIATION, INC.

Surveyed July 11, 1973, by L. E. Gould