


T.27S., R.11W., W.M.

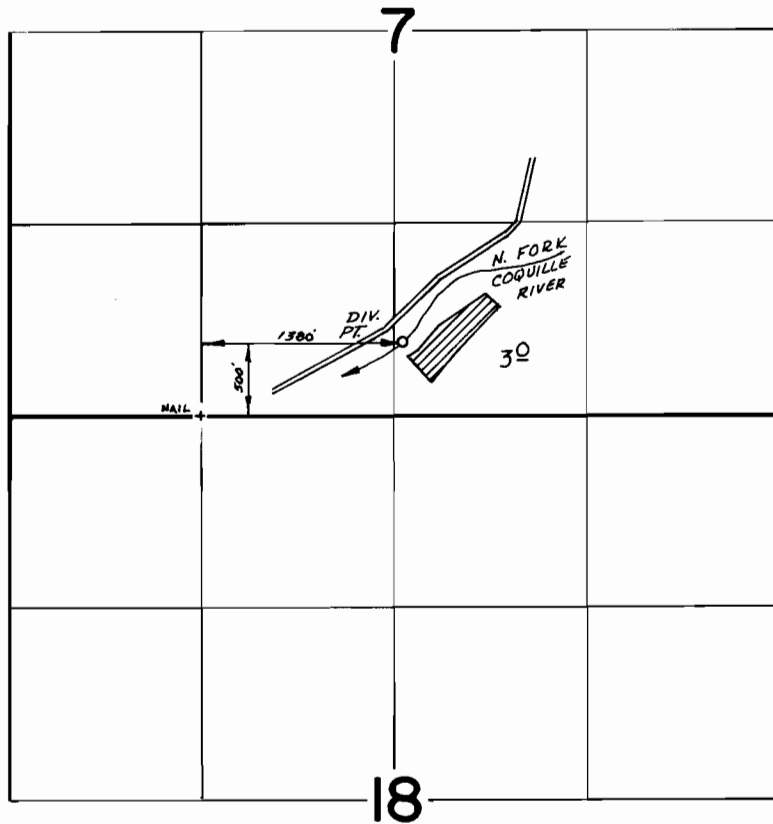

**FINAL PROOF SURVEY**  
UNDER

Application No. 48244 Permit No. 36227  
IN NAME OF  
HAL STRAIN

Surveyed July 17 1976, by D. Norby