


T.28S., R.10W., W.M.

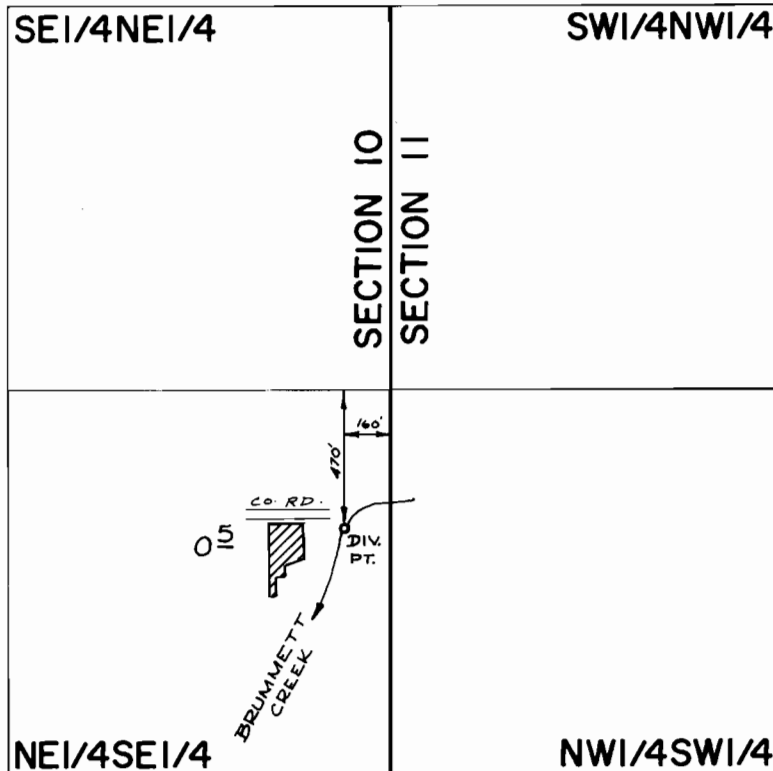

Scale: 1" = 660'

**FINAL PROOF SURVEY**  
UNDER

Application No. 50428 Permit No. 38088  
IN NAME OF

EDWARD L. HOWELL

Surveyed July 22 1976, by D. Norby