


T.27S. R.14W. W.M.

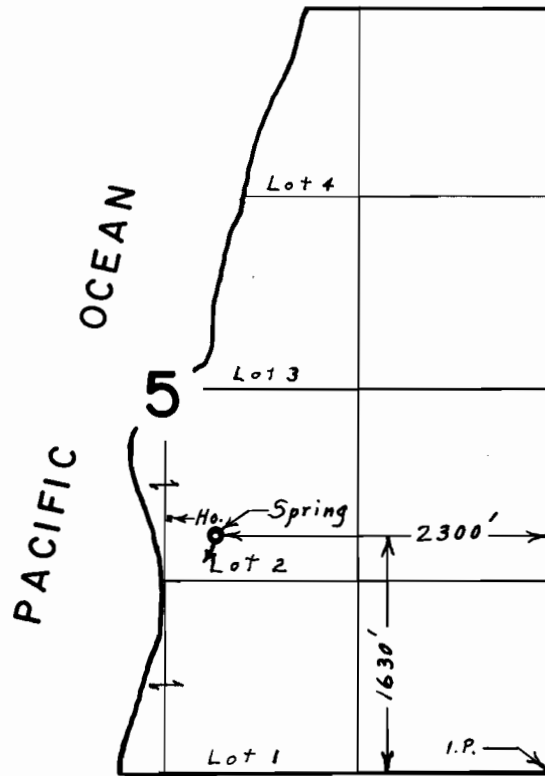

**FINAL PROOF SURVEY**  
UNDER

Application No. 51837.. Permit No. 39032..  
IN NAME OF

**DOUGLAS L. & ELEANOR WILFERT**

Surveyed July 14., 1976., by L. E. Gould..