

# LAPINE STATE REC. AREA


## WATER RIGHT APPLICATION

DESCHUTES COUNTY

T.21S., R. 10 E., W.M.

4" = 1 Mi.

12-22-67

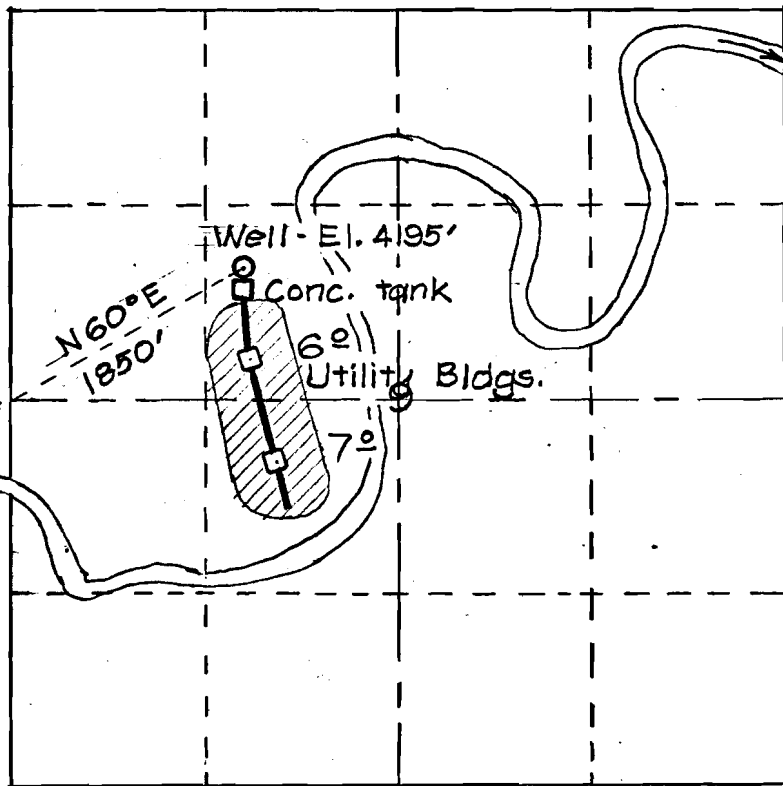

Deschutes River

Well - El. 4195'

Conc. tank

Utility Bldgs.

N60°E  
1850'

6'

7'

2 1/2" Capped Pipe

No. G-4179

G-3928

**RECEIVED**  
 JAN 12 1968  
 STATE ENGINEER  
 SALEM OREGON

#3

G-3928