


T.32S. R.4W. W.M.

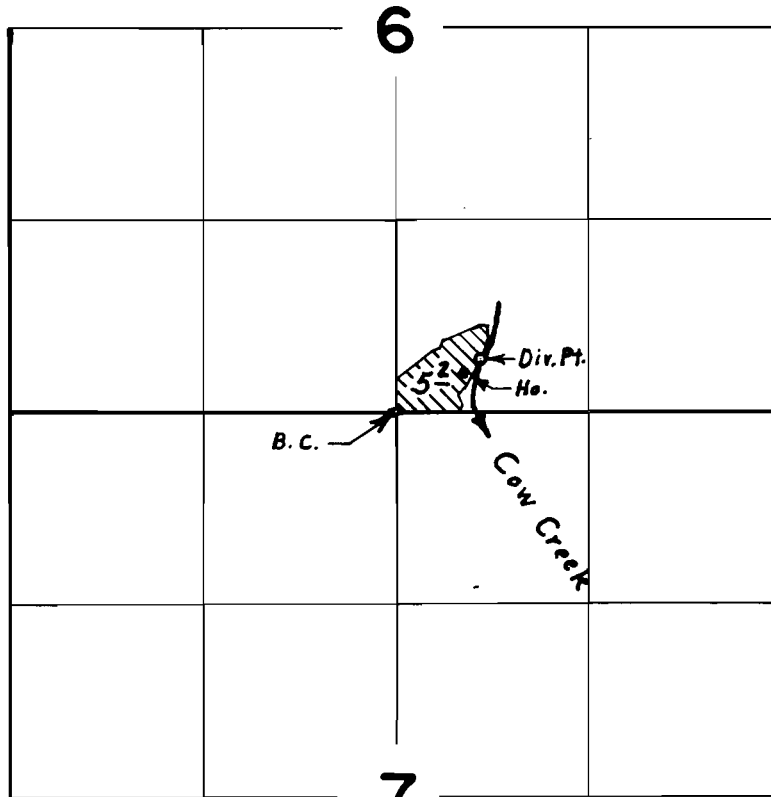

Div. Pt. located 360' N. & 300' E. from S. $\frac{1}{4}$ Corner Section 6

FINAL PROOF SURVEY
UNDER

Application No. 43230. Permit No. 32318.
IN NAME OF

Ronald A. & Sharlene A. Flackman

Surveyed May 14, 1976, by L. E. Gould