


T.23S.R.7&8W.W.M.

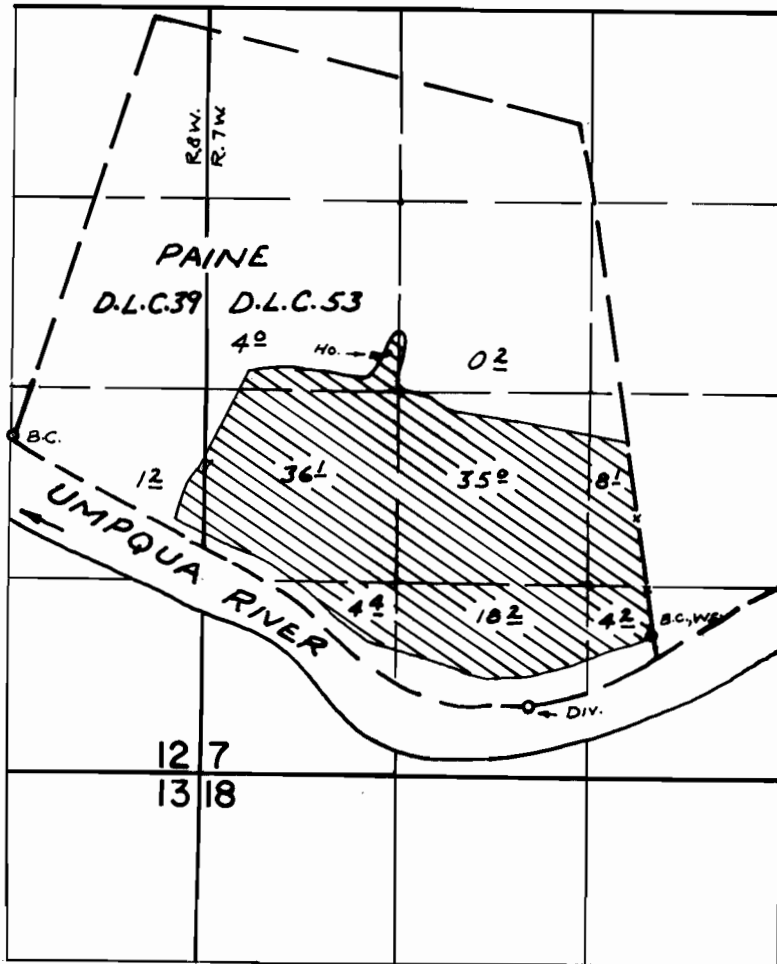

DIV. Loc: 430'S. & 870'W. FROM S.E. COR. D.L.C. 53

FINAL PROOF SURVEY UNDER

Application No. 43858 Permit No. 32772
IN NAME OF

MRS. MILDRED COMFORT

Surveyed MAY 13, 1976, by R. MUCKEN