


# T.22S.,R.10W.,W.M.

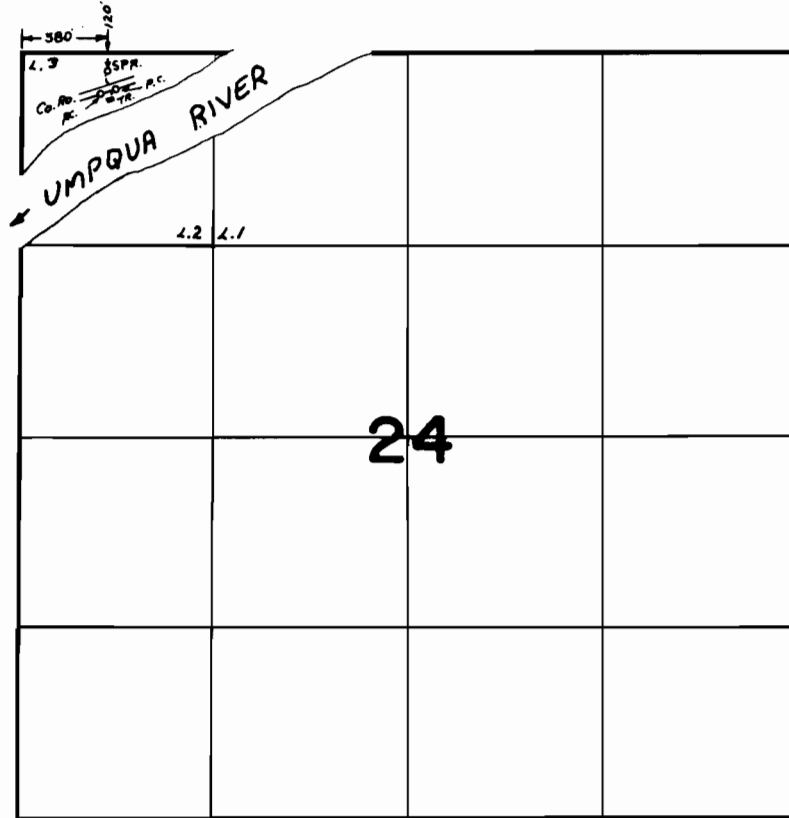

## FINAL PROOF SURVEY UNDER

Application No. 46680. Permit No. 34872.  
IN NAME OF

JOHN D. LOCKE

Surveyed *May 25* 1976, by *L. Tolt*