


T.26S. R.7W. W.M.

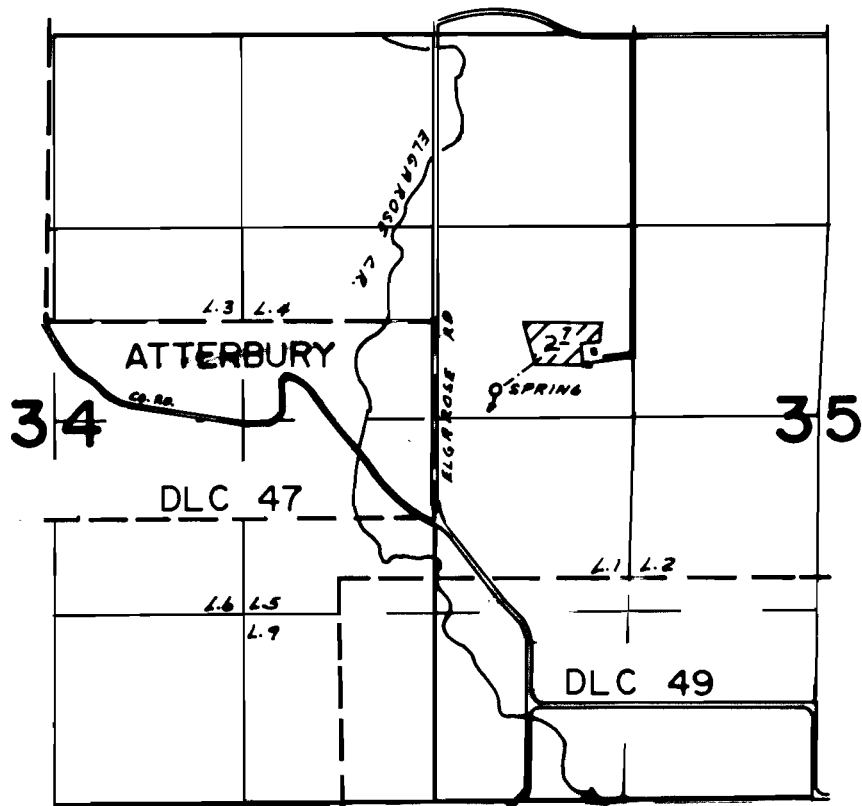

SPRING LOC. 480' S. & 410' E FROM E'LY, NE COR
ATTERBURY DLC 47

FINAL PROOF SURVEY
UNDER

Application No. 47791..... Permit No. 35806.....
IN NAME OF

WESLEY G. & CAROL L. NEWMAN

Surveyed APR..8... 1976., by L.H. NUNN.....