


T.28S., R.4W., W.M.

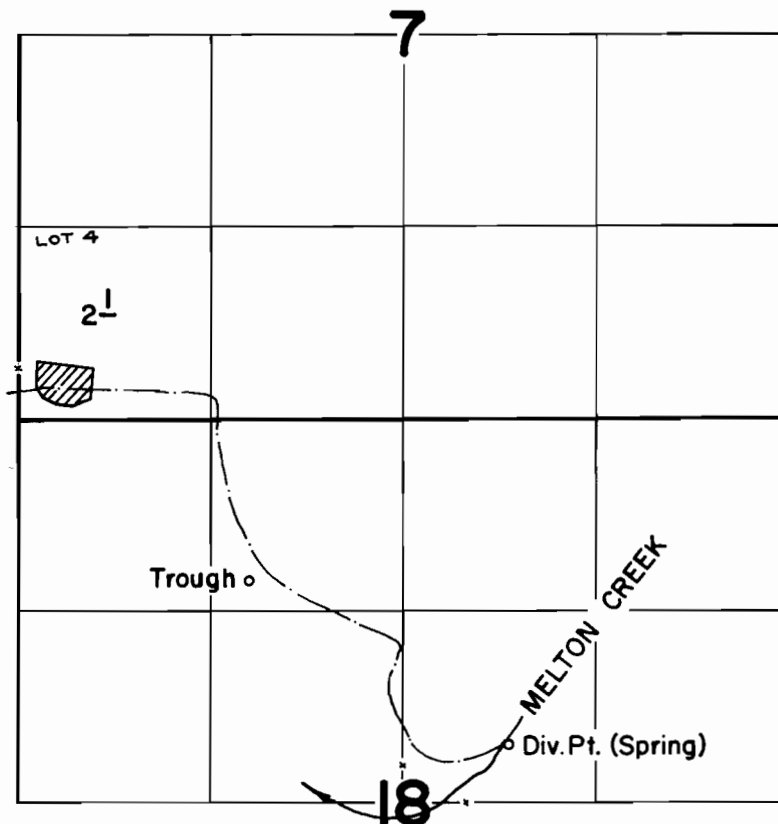

DIV. PT. LOC: 390'N & 730'E FROM CENTER SEC. 18

FINAL PROOF SURVEY
UNDER

Application No. 48052 Permit No. 36031
IN NAME OF

ROBERT A. HALL

Surveyed April 6 1976, by D. Norby