


T. 22 S. R. 5 W. W.M.

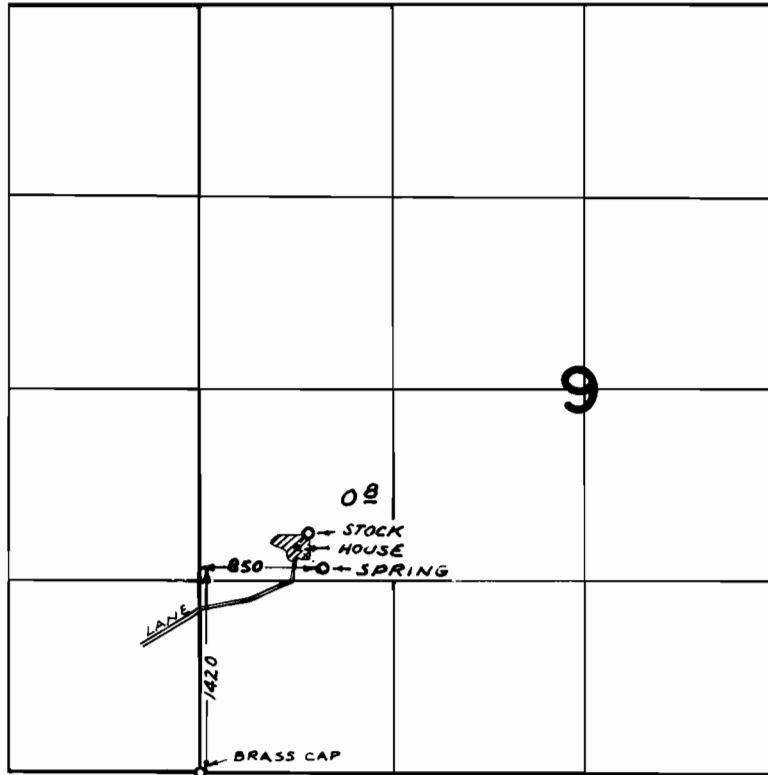

FINAL PROOF SURVEY UNDER

Application No. ~~40084~~ Permit No. 36625
IN NAME OF

.....KATHLEEN A. RACE.....

Surveyed MAY 29, 1976, by R. MUCKEN