


T.28S. R.7W. W.M.

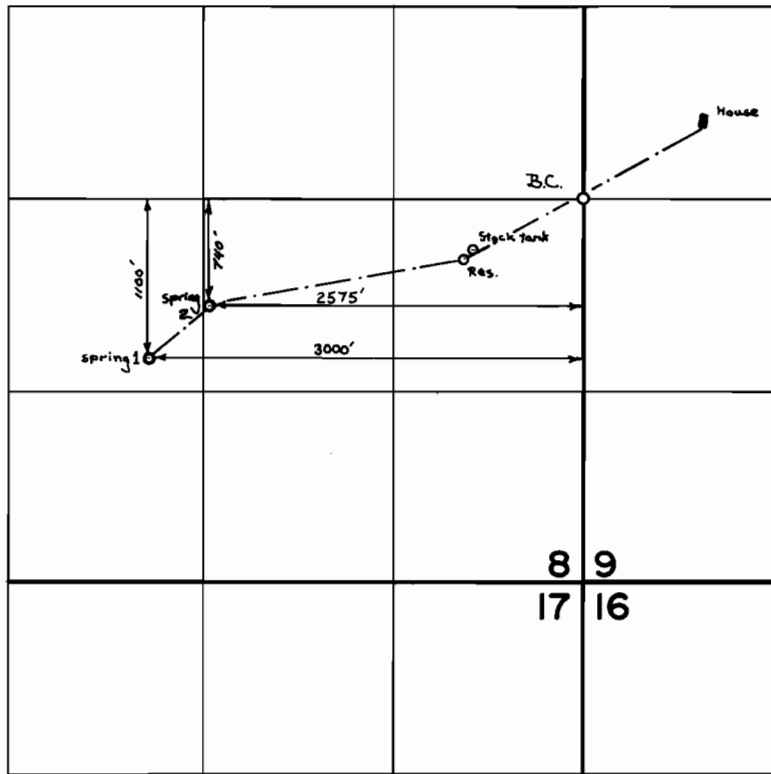

FINAL PROOF SURVEY UNDER

Application No. 49904 Permit No. 37553
IN NAME OF

WALTER B. SMITH, SR.

Surveyed July 27, 1976, by L.E. Gould