


T.29S. R.5W. W.M.

SEC. 23

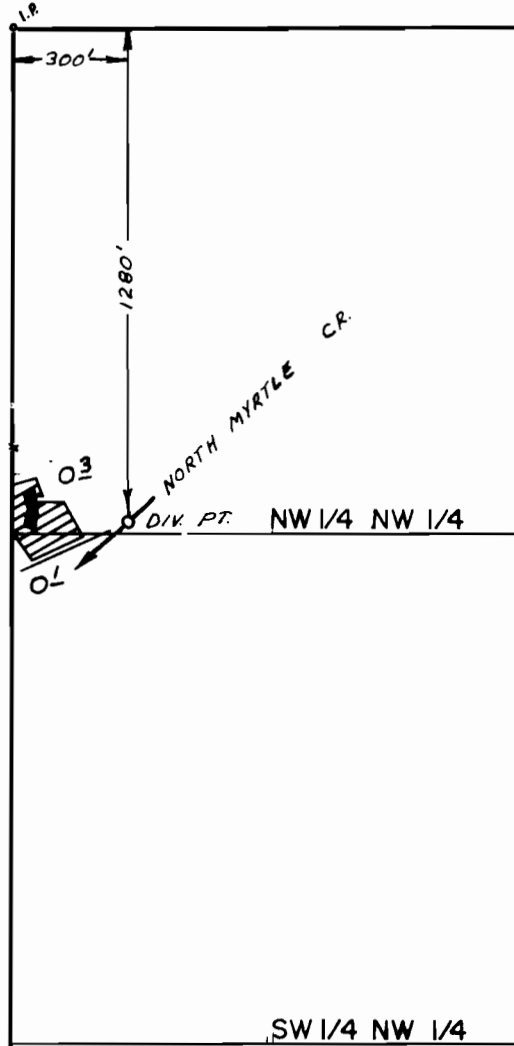

SCALE 1" = 500'

FINAL PROOF SURVEY
UNDER

Application No. 50642 Permit No. 38264
IN NAME OF

KENNETH L. & ELAINE M. GASTON

Surveyed OCT. 7 1976, by L.H. NUNN