


T.28S R.6W. W.M.

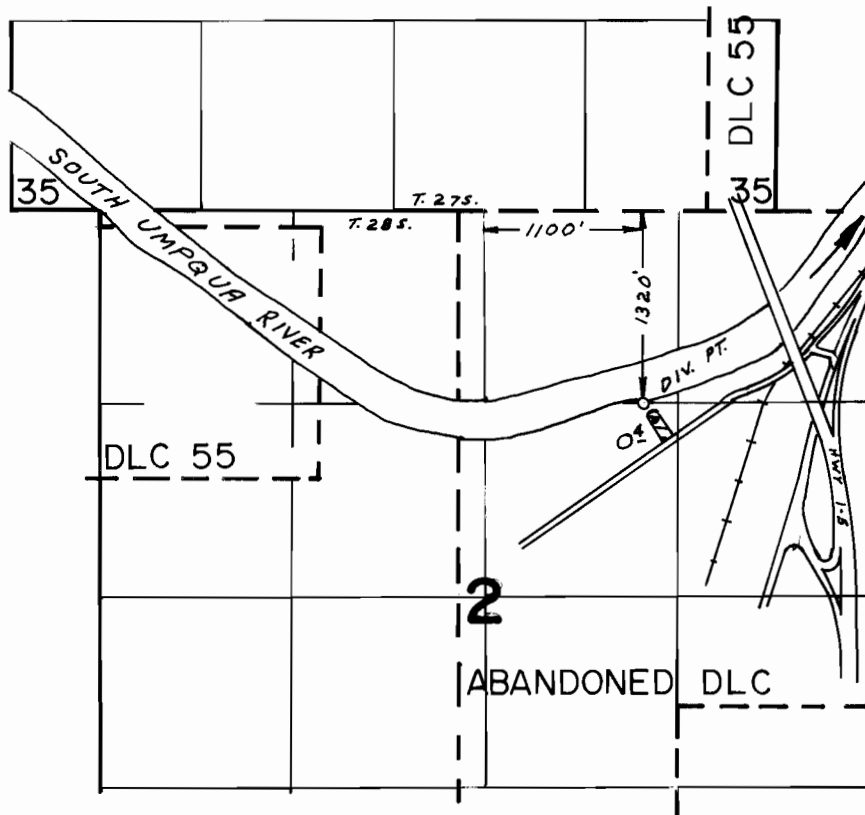

**FINAL PROOF SURVEY**  
UNDER

Application No. 50988... Permit No. 38484...  
IN NAME OF

.....LAWRENCE H. RILEY.....

Surveyed APR...7... 1976, by L.H. NUNN.....