


T.29S. R.5W. W.M.

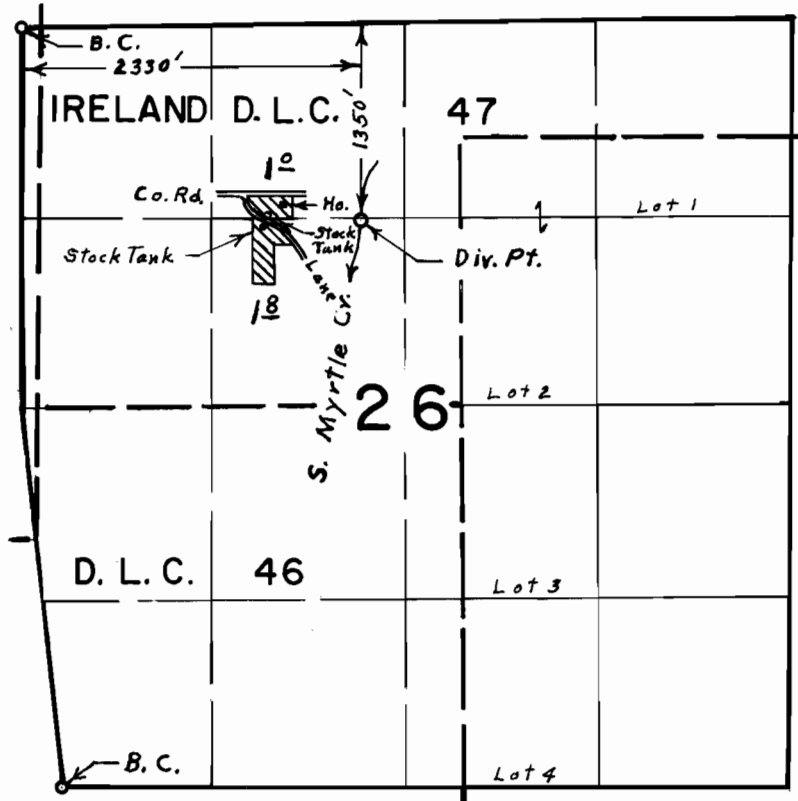

**FINAL PROOF SURVEY**  
UNDER

Application No. 50996. Permit No. 38491.  
IN NAME OF  
JEROME B. WILSON

Surveyed May 28, 1976, by L. E. Gould.