


T.28S. R.6W. W.M.

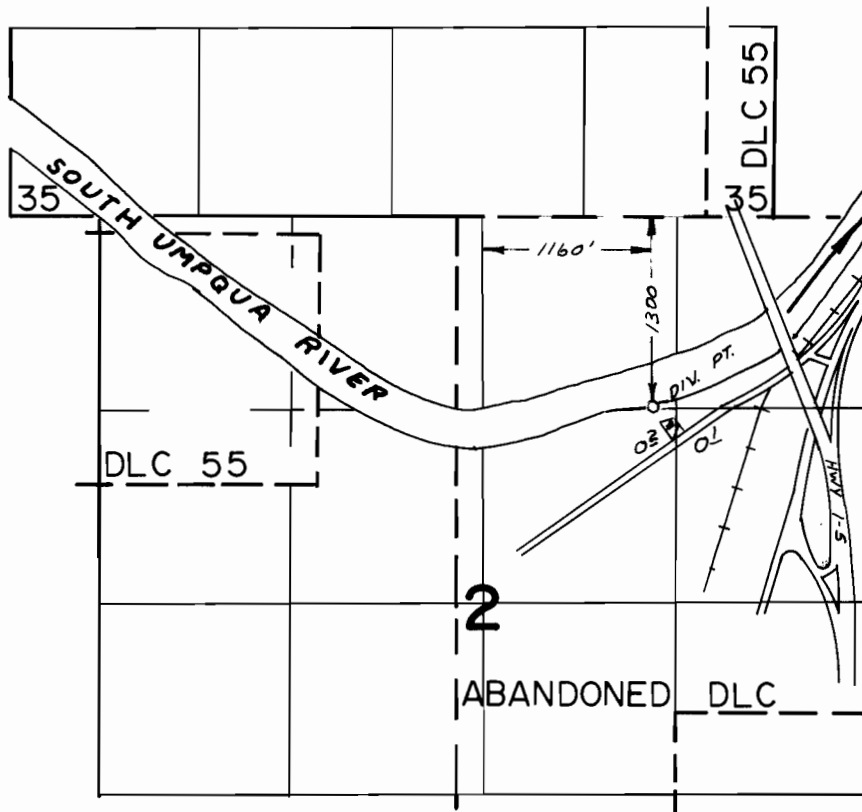

FINAL PROOF SURVEY
UNDER

Application No. 51034..... Permit No. 38516.....
IN NAME OF

H.M. & MARGUERITE MONROE

Surveyed APR. 7. 1976, by L.H. NUNN