


T.33S. R.6W. W.M.

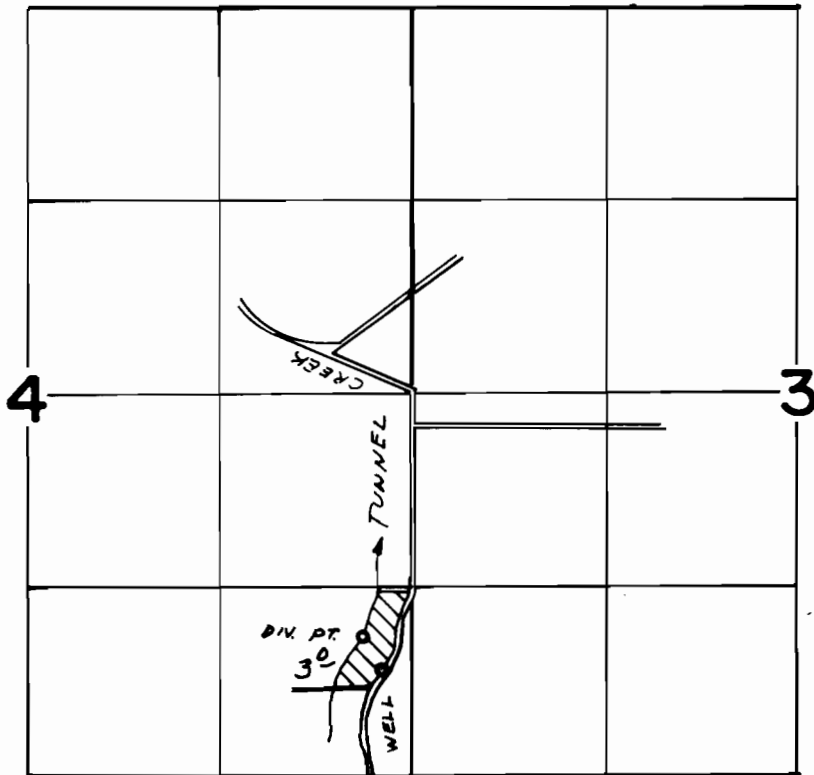

DIV. PT. LOC. 970' N. & 340' W, WELL LOC. 740' N. & 210' W,  
BOTH FROM SE CORNER, SECTION 4.

**FINAL PROOF SURVEY**  
UNDER

51274

38721

Application No. G-6001... Permit No. G-5745..  
IN NAME OF

EDWARD J. & LUCILLE HARRIS

Surveyed JULY 13, 1976, by L.H. MUNN