


# T.26S. R.6W. W.M.

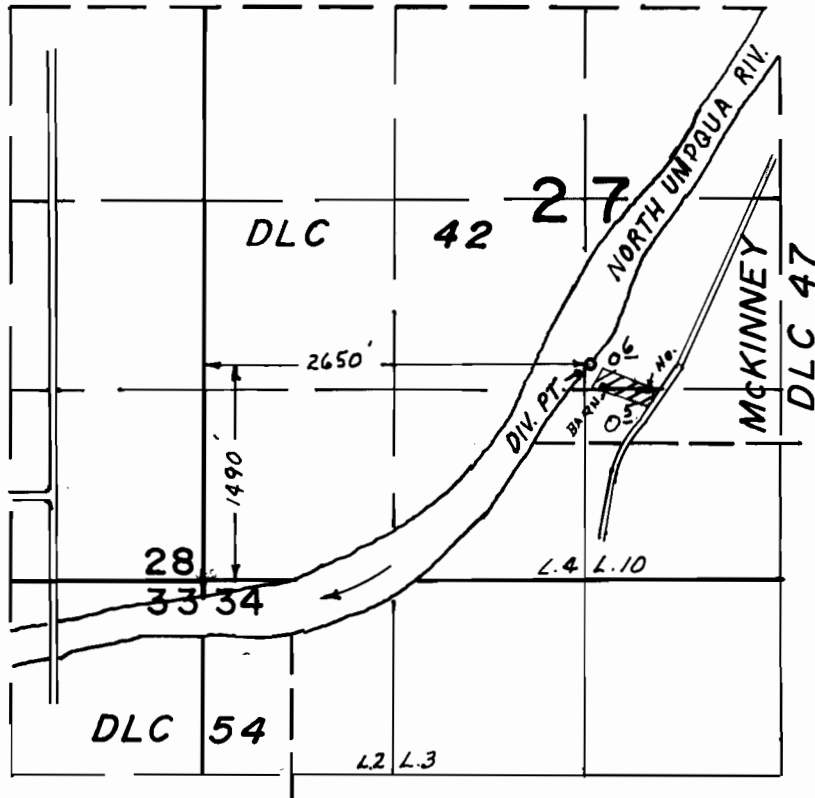

## FINAL PROOF SURVEY UNDER

Application No. 51312 Permit No. 38743  
IN NAME OF

STANLEY B. & EDITH M. STEVENS

Surveyed APR. 6 1976, by L.H. NUNN