


T28 & 29S. R.6W. W.M.

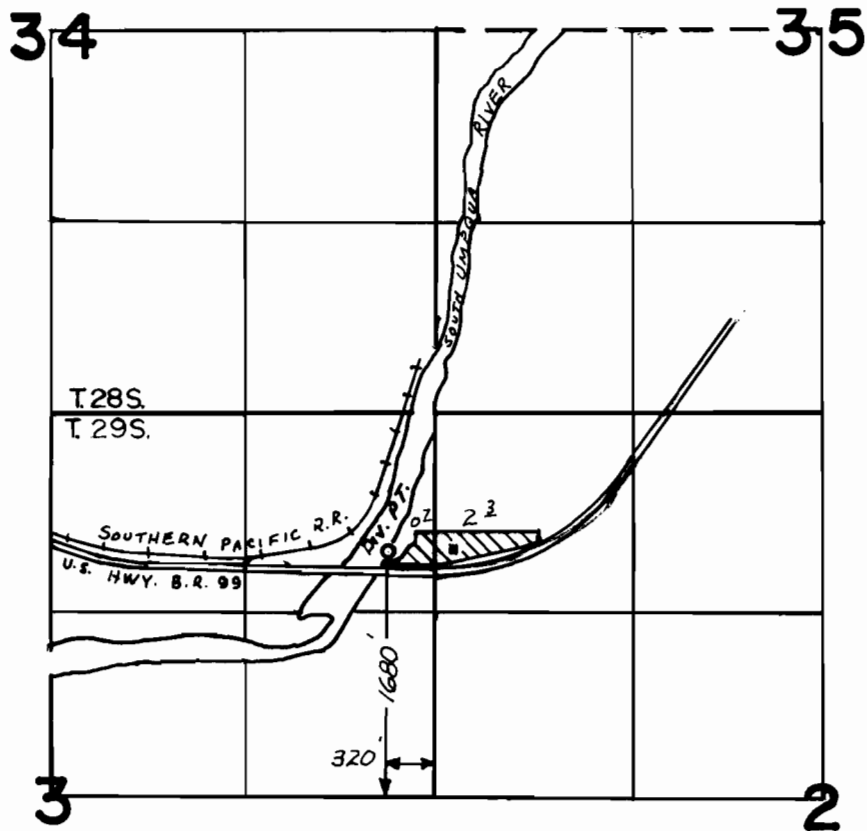

FINAL PROOF SURVEY UNDER

Application No. 51595..... Permit No. 38917.....
IN NAME OF

.....**MARVIN G. DEVORE**.....

Surveyed **APR. 7** 1976, by **L.H. NUNN**.....